

WARREN
 B 2002
 4-9-78

MISSISSIPPI
 BOARD OF WATER COMMISSIONERS
 416 North State Street
 Jackson, Mississippi 39201

WATER WELL DRILLERS LOG

4-9 1978 E.M. "Bud" Cresswell Warren
 date well completed firm name county well located


LANDOWNER:	description of formations encountered	from	to
Anderson-Tully Co. Vicksburg, MS. (mailing address)			
WELL LOCATION:			
sec. 18 T 18 N R 4 E 5 miles West of Redwood (distance) (direction) (nearest town)			
WELL PURPOSE: Farm (home, irrigation, municipal, industrial)			
WELL COMPLETION DATA:			
(1) diameter (inches) 2			
(2) total depth (feet) 85			
(3) static water level (feet) 18 below top of ground.			
(4) casing PVC 80 (material) (depth)			
2 If telescope see back. (size)			
(5) screen 5 80 (length) (depth to top)			
2 PVC (size) (material)			
(6) pump 1 10 (HP) (yield gpm)			
70 (type power)			
(7) electric log 70 (yes or no)			
(organization running log)			
(8) how well bottom plugged Back wash valve			
DRILLERS REMARKS:			

RECEIVED
 MAY 3 - 1978

MISS. BD. OF WATER COMMISSIONERS

If well telescopes please sketch and show depths.

GROUND LEVEL

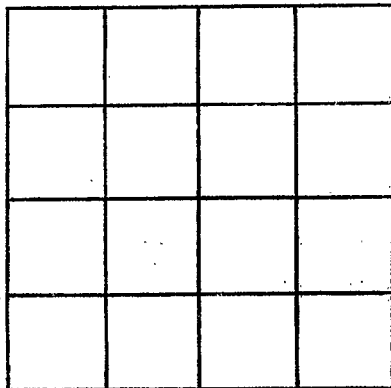

SECTION _____

Please indicate well location X.

ADDITIONAL INFORMATION

If more than one screen,
show locations of each on sketch.