

WARREN
 B 2003
 12-1-78

MISSISSIPPI
 BOARD OF WATER COMMISSIONERS
 416 North State Street
 Jackson, Mississippi 39201

WATER WELL DRILLERS LOG

Dec. 1 1978 F.M. "Bud" CRESWELL WARREN
 date well completed firm name county well located


LANDOWNER:	description of formations encountered	from	to
Mrs. D.C. Raines Redwood, Ms. (mailing address)	Clay Sand & gravel	0	20 20 / 20
WELL LOCATION: sec 7 T 18 N R 4 E 3 miles West of Redwood (distance) (direction) (nearest town)			
WELL PURPOSE: home (home, irrigation, municipal, industrial)			
WELL COMPLETION DATA:			
(1) diameter (inches) 2			
(2) total depth (feet) 120			
(3) static water level (feet) 10 below top of ground			
(4) casing PVC 110 (material) (depth) 2 (size) If telescope see back.			
(5) screen 10 110 (length) (depth to top) 2 PVC (size) (material)			
(6) pump 1 10 (HP) (yield gpm) 0 (type power)			
(7) electric log No (yes or no)			
(organization running log)			
(8) how well bottom plugged Pvc plug			
DRILLERS REMARKS:			

RECEIVED
 DEC - 5 1978

MISS. BD. OF WATER COMMISSIONERS

If well telescopes please
sketch and show depths.

GROUND LEVEL

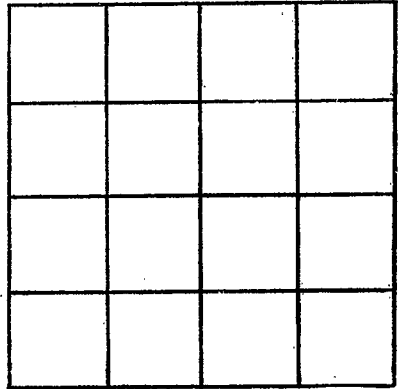

SECTION _____

Please indicate well location X.

ADDITIONAL INFORMATION

If more than one screen,
show locations of each on sketch.