

WARREN
B 2004
6-20-79

MISSISSIPPI
BOARD OF WATER COMMISSIONERS
416 North State Street
Jackson, Mississippi 39201

WATER WELL DRILLERS LOG

6/20 1979 E.M. "Bud" Cresswell Warren
date well completed firm name county well located

LANDOWNER:
Felix Bounds
Redwood, Ms.
(mailing address)

description of formations encountered	from	to
Clay	0	40
Sand-gravel	40	110

WELL LOCATION:
sec 33 T 18 N R 4 E
1 miles West Redwood
(distance) (direction) (nearest town)

WELL PURPOSE: home
(home, irrigation, municipal, industrial)

WELL COMPLETION DATA:

(1) diameter (inches) 2

(2) total depth (feet) 110

(3) static water level (feet) 18 below top of ground.

(4) casing PVC 110
(material) (depth)

2 (size) if telescope see back.

(5) screen 10 100
(length) (depth to top)

2 PVC
(size) (material)

(6) pump 3/4 10
(HP) (yield gpm)

0 (type power)

(7) electric log no
(yes or no)

(organization running log)


(8) how well bottom plugged
Steel plug

DRILLERS REMARKS:

Miss. Board of Water Comm.
JUL 5 1979
RECEIVED

If well telescopes please sketch and show depths.

GROUND LEVEL

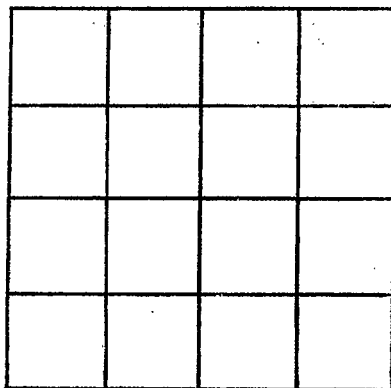

SECTION _____

Please indicate well location X.

ADDITIONAL INFORMATION

If more than one screen, show locations of each on sketch.