

MISSISSIPPI DEPARTMENT OF NATURAL RESOURCES

Bureau of Land and Water Resources

Southport Mall

P.O. Box 10631

Jackson, Mississippi 39209

WATER WELL DRILLERS LOG

Warren  
B 0005

May 21 1982 R.M. "Bud" Cresswell Warren  
date well completed firm name county well located

LANDOWNER:  
Don Sibley  
Redwood, MS.  
(mailing address)

description of formations encountered	from	to
<u>gumbo</u>	<u>0</u>	<u>35</u>
<u>hard-gravel</u>	<u>35</u>	<u>120</u>

WELL LOCATION:  
sec 23 T 18 N R 4 E  
1 miles NW of Redwood  
(distance) (direction) (nearest town)

WELL PURPOSE: Home  
(home, irrigation, municipal, industrial)

- WELL COMPLETION DATA:
- (1) diameter (inches) 2
  - (2) total depth (feet) 120
  - (3) static water level (feet) 20 below top of ground.
  - (4) casing PVC 110  
(material) (depth)  
2 if telescope see back.  
(size)
  - (5) screen 10 110  
(length) (depth to top)  
2 PVC  
(size) (material)
  - (6) pump None  
(HP) (yield gpm)  
(type power)
  - (7) electric log \_\_\_\_\_  
(yes or no)  
(organization running log)
  - (8) how well bottom plugged  
hard shale

DRILLERS REMARKS: \_\_\_\_\_


DEPT. OF NATURAL RESOURCES  
BUREAU OF LAND & WATER RESOURCES

JUN - 8 1982

RECEIVED

If well telescopes please  
sketch and show depths.

GROUND LEVEL

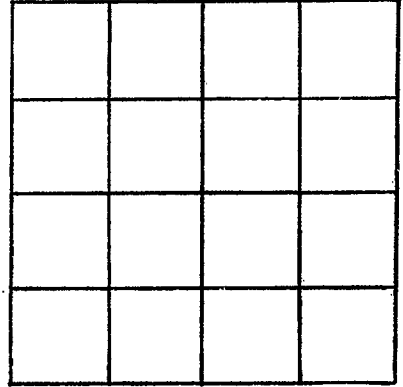

SECTION \_\_\_\_\_

Please indicate well location X.

ADDITIONAL INFORMATION

If more than one screen,  
show locations of each on sketch.