

Warren
B
2000

MISSISSIPPI DEPARTMENT OF NATURAL RESOURCES
Bureau of Land and Water Resources
Southport Mall
P.O. Box 10631
Jackson, Mississippi 39209
WATER WELL DRILLERS LOG

Dec. 7 1983 E.M. Bud Cresswell WARREN
date well completed firm name county well located

LANDOWNER:	description of formations encountered	from	to
Charles Selby Redwood, MS. (mailing address)	Clay - Sand - gravel	0 30	30 120
WELL LOCATION: sec. 16 T 18 N R 4 E 3 miles North of Redwood (distance) (direction) (nearest town)			
WELL PURPOSE: home (home, irrigation, municipal, industrial)			
WELL COMPLETION DATA:			
(1) diameter (inches) 2			
(2) total depth (feet) 120			
(3) static water level (feet) 20 below top of ground.			
(4) casing PVC, 110 (material), (depth), 2 (size) if telescope see back.			
(5) screen 10, 110 (length), (depth to top), 2, PVC (size), (material)			
(6) pump 1, 10 (HP), (yield gpm)			
(type power)			
(7) electric log no (yes or no)			
(organization running log)			
(8) how well bottom plugged Jack wash water			
DRILLERS REMARKS:			


MISSISSIPPI DEPT. OF NATURAL RESOURCES
BUREAU OF LAND & WATER RESOURCES

JAN 5 - 1984

RECEIVED

If well telescopes please sketch and show depths.

GROUND LEVEL

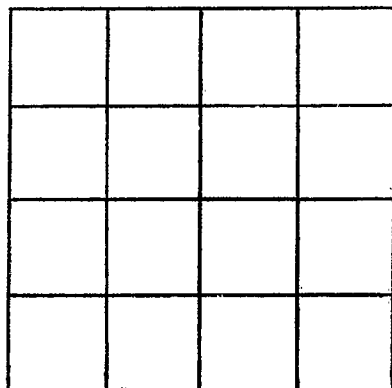

SECTION _____

Please indicate well location X.

ADDITIONAL INFORMATION

If more than one screen,
show locations of each on sketch.