

WARREN
B 207

MISSISSIPPI DEPARTMENT OF NATURAL RESOURCES
 Bureau of Land and Water Resources
 Southport Mall
 P.O. Box 10631
 Jackson, Mississippi 39209
WATER WELL DRILLERS LOG

Feb. 4, 1966 E.M. "Bud" Cresswell Warren
 date well completed firm name county well located

LANDOWNER:
Charles Blackledge
Redwood, Ms.
 (mailing address)

description of formations encountered	from	to
Surface	0	75
SAND-GRAVEL	75	120

WELL LOCATION:
 sec 34 1/2 N R 4 E
1 miles North of Redwood
 (distance) (direction) (nearest town)

WELL PURPOSE: Home
 (home, irrigation, municipal, industrial)

WELL COMPLETION DATA:

(1) diameter (inches) 4

(2) total depth (feet) 120

(3) static water level (feet) 27 below top of ground


(4) casing PVC 100
 (material) (depth)
4 If telescope see back.
 (size)

(5) screen 20 100
 (length) (depth to top)
4 PVC
 (size) (material)

(6) pump 1 20
 (HP) (yield gpm)
0
 (type power)

(7) electric log No
 (yes or no)
 (organization running log)

(8) how well bottom plugged
Back Wash Valve

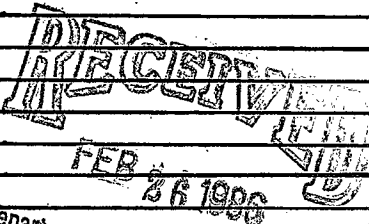


DRILLERS REMARKS:

Department of Natural Resources
 Bureau of Land & Water Resources

If well telescopes please sketch and show depths.

GROUND LEVEL

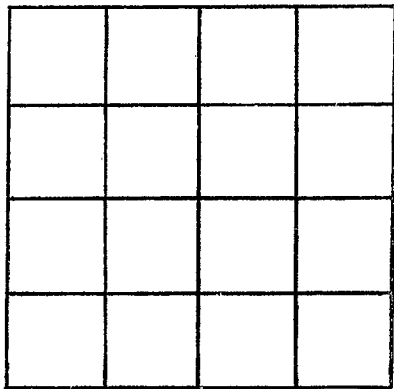

SECTION _____

Please indicate well location X.

ADDITIONAL INFORMATION

If more than one screen, show locations of each on sketch.