

MISSISSIPPI DEPARTMENT OF NATURAL RESOURCES

Bureau of Land and Water Resources

Southport Mall

P.O. Box 10631

Jackson, Mississippi 39209

WATER WELL DRILLERS LOG

WARREN
B 2008

Nov. 6 1986 E.M. Bud Cresswell WARREN
date well completed firm name county well located

LANDOWNER:	description of formations encountered	from	to
<u>Austin Braswell</u> <u>Redwood, MS.</u> (mailing address)			
	<u>Sand-gravel</u>	<u>30</u>	<u>160</u>
	<u>Blue clay</u>	<u>160</u>	<u>680</u>
	<u>Shale. sea shells</u>	<u>680</u>	<u>710</u>
	<u>Tough. Shale.</u>	<u>710</u>	<u>760</u>
	<u>Sandy Shale.</u>	<u>760</u>	<u>870</u>
	<u>Sand</u>	<u>870</u>	<u>915</u>
WELL LOCATION: sec. <u>16</u> T. <u>18</u> N R. <u>4</u> W <u>4</u> miles <u>N</u> of <u>Redwood</u> (distance) (direction) (nearest town)			
WELL PURPOSE: <u>home</u> (home, irrigation, municipal, industrial)			
WELL COMPLETION DATA:			
(1) diameter (inches) <u>4</u>			
(2) total depth (feet) <u>915</u>			
(3) static water level (feet) <u>20</u> below top of ground.			
(4) casing <u>PVC</u> , <u>885</u> (material) (depth)			
<u>4</u> if telescope see back. (size)			
(5) screen <u>30</u> , <u>885</u> (length) (depth to top)			
<u>2</u> , <u>PVC</u> (size) (material)			
(6) pump <u>1</u> , <u>10</u> (HP) (yield gpm)			
(type power)			
(7) electric log <u>no</u> (yes or no)			
(organization running log)			
(8) how well bottom plugged <u>Back Wash</u>			

RECEIVED


NOV 18 1986

Department of Natural Resources
Bureau of Land & Water Resources

DRILLERS REMARKS:

If well telescopes please sketch and show depths.

GROUND LEVEL

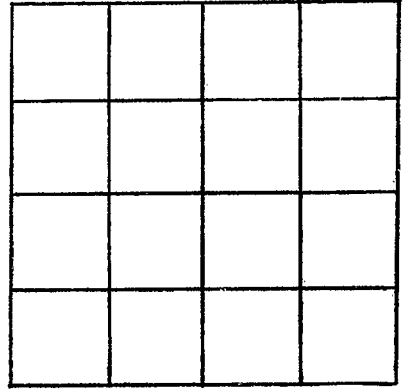

SECTION _____

Please indicate well location X.

ADDITIONAL INFORMATION

If more than one screen,
show locations of each on sketch.