

MISSISSIPPI DEPARTMENT OF NATURAL RESOURCES

Bureau of Land and Water Resources

Southport Mall

P.O. Box 10631

Jackson, Mississippi 39209

WATER WELL DRILLERS LOG

WARREN
B 2009

Nov. 10 1986 E.M. BUD CRESSWELL WARREN
date well completed firm name county well located

LANDOWNER:	description of formations encountered	from	to
Jay B. Morgan Redwood, Ms. (mailing address)			
WELL LOCATION: sec. 16 T 18 N R 4 E 4 miles North of Redwood (distance) (direction) (nearest town)			
WELL PURPOSE: <u>house</u> (home, irrigation, municipal, industrial)			
WELL COMPLETION DATA:			
(1) diameter (inches) <u>2</u>			
(2) total depth (feet) <u>130</u>			
(3) static water level (feet) <u>25</u> below top of ground.			
(4) casing <u>PVC</u> <u>120</u> (material) (depth)			
<u>2</u> if telescope see back. (size)			
(5) screen <u>10</u> <u>120</u> (length) (depth to top)			
<u>2</u> <u>PVC</u> (size) (material)			
(6) pump <u>1</u> <u>10</u> (HP) (yield gpm)			
(type power)			
(7) electric log <u>no</u> (yes or no)			
(organization running log)			
(8) has well bottom plugged <u>Back wash</u>			
DRILLERS REMARKS:			


RECEIVED

NOV 18 1986

Department of Natural Resources
Bureau of Land & Water Resources

If well telescopes please sketch and show depths.

GROUND LEVEL

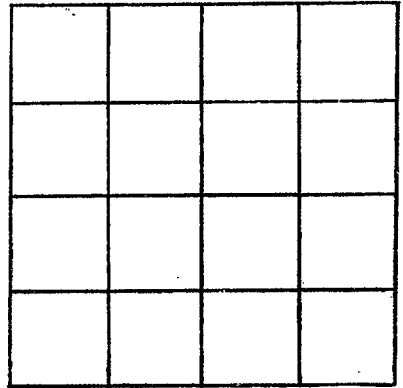

SECTION _____

Please indicate well location X.

ADDITIONAL INFORMATION

If more than one screen,
show locations of each on sketch.