

MISSISSIPPI DEPARTMENT OF NATURAL RESOURCES

Bureau of Land and Water Resources

Southport Mall

P.O. Box 10631

Jackson, Mississippi 39209

WATER WELL DRILLERS LOG

WARREN
B 2011

Aug. 25 1988 E.M. Reid GRESSWELL WARREN
date well completed firm name county well located

LANDOWNER:	description of formations encountered	from	to
JASON DANIELS Redwood, MS. (mailing address)			
WELL LOCATION:			
sec 33 T 88 N R 4 E 1 miles West of Redwood (distance) (direction) (nearest town)			
WELL PURPOSE: home (home, irrigation, municipal, industrial)			
WELL COMPLETION DATA:			
(1) diameter (inches) 4			
(2) total depth (feet) 120			
(3) static water level (feet) 22 below top of ground.			
(4) casing PVC, 100 (material) (depth) 4 (size) if telescope see back.			
(5) screen 20, 100 (length) (depth to top) 4, PVC (size) (material)			
(6) pump 1, 20 (HP) (yield gpm) (type power)			
(7) electric log NO (yes or no) (organization running log)			
(8) how well bottom plugged Sand Shale			

RECEIVED


SEP 20 1988

Department of Natural Resources
Bureau of Land and Water Resources

DRILLERS REMARKS:

If well telescopes please sketch and show depths.

GROUND LEVEL

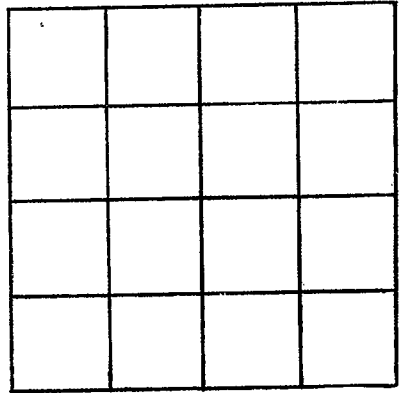

SECTION _____

Please indicate well location X.

ADDITIONAL INFORMATION

If more than one screen,
show locations of each on sketch.