

MISSISSIPPI DEPARTMENT OF ENVIRONMENTAL QUALITY
Bureau of Land and Water Resources

P. O. Box 10631
Jackson, MS 39289-0631
WATER WELL DRILLERS LOG

COUNTY WELL LOCATED WARREN	
WELL NUMBER B 2013	CODED
DATE WELL COMPLETED Aug. 4, 1992	

PERMIT NUMBER
NAME OF DRILLING FIRM CRESSWELL

NAME & MAILING ADDRESS OF LANDOWNER Tony Britt			
Cotton Land Ranch			
Vicksburg, MS -			
WELL LOCATION: SEC	TOWNSHIP	RANGE	
21	18 N	4 E	
DISTANCE	DIRECTION	NEAREST TOWN	
2 Miles	North	Redwood	
OTHER LANDMARK			
WELL PURPOSE: Home, Irrigation, Municipal, Industrial, Fish Pond, etc. Stock			

PUMP DATA		
PUMP TYPE (Circle One): Submersible Turbine, Jet, Flowing Well, Other (Describe)		
POWER TYPE (Circle One): Electric , Tractor, Diesel, Gasoline, Butane, Other (Describe) H/P 1		
Pump Capacity (GPM) 20	No. of Stages 11	Setting Depth 60 FT.
PUMP TEST		
Well yielded 60 GPM with a drawdown of 10 ft. after 1/2 hours of pumping		

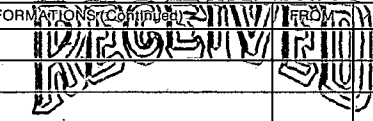
WELL DATA		
Well Depth 140	Casing Diameter (In.) 4	Casing Length (Ft.) 120
Type of Casing PVC	Hole Depth 140	Depth to Static Water Level 18
TYPE OF COMPLETION: (Circle One or More): Natural Development , Gravel Packed, Underreamed, Telescoped, Open Hole, Other		
Top of Lap Pipe or Reduction in Casing FEET IF TELESKOPED OR MORE THAN ONE SCREEN: USE BACK PAGE		

LOG DATA	
TYPE OF LOG RUN (Circle One): No Log Run , Electric, Gamma Ray, Density, Sonic, Neutron, Other (Describe)	
Name of Organization Running Log	

SCREEN DATA		
Diameter - Inches 4	Length - Feet 20	Slot Size - Inches .016
Screen Type PVC	Depth to Bottom - Feet 140	

GEOLOGIC DATA (Office Use Only)			
Surface Elev.	Geologic Unit	Unit Thickness	Depth to Top
Subs. SWL	Date	Analysis	Aquifer Test

Driller's Remarks

DESCRIPTION OF FORMATIONS ENCOUNTERED	FROM	TO	FORMATIONS (Continued)	FROM	TO
Surface Deposit	0	12			
sand-gravel	12	140			
			SEP 02 1992		
Dept. of Environmental Quality Bureau of Land & Water Resources					
IF MORE SPACE IS NEEDED, USE BACK					

If well telescopes please
sketch and show depths.

GROUND LEVEL

SECTION _____

Please indicate well location X.

ADDITIONAL INFORMATION

If more than one screen,
show location of each on sketch.