

WARREN

MISSISSIPPI BOARD OF WATER COMMISSIONERS

32017

WATER WELL DRILLERS LOG

10-4-60


B (or) C

Date: 10-4, 1960, Driller: P. G. ... County ...

(1) Owner of Land: Albert Henry ... (Name)
Unkbuy miss ... (Address)
(2) Location: 1/4, 1/4, Sec. 8 TR
10 miles ... of ... (distance) (direction) (Nearest Town)
(3) Topography: Flat ... (Hilly) (Flat) (Level)
(4) Purpose of Well: Stock ... (Domestic Irrigation) (Municipal, Industrial, Other)

Table with 3 columns: Description & Color of Materials, Thickness Feet, Depth Feet. Handwritten notes: 0-104 clay, 104-111 sand.

Information upon completion of well:
(1) Diameter 2 inches.
(2) Total Depth 111 feet.
(3) Water Level 31 feet below top of ground.
(4) Cased to 111, Size 2
(5) Screen: Size 2, Length 6
(6) Were any formations sealed against pollution?
yes, NO no.
If YES depth of formation
Why
Drillers Remarks:

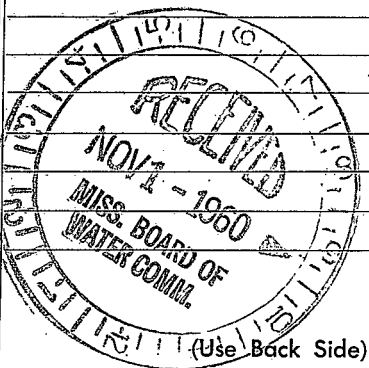

Well No.

