

C10

JES.

ELOG#84

DEC 18 1968

MISS. BD. CODED  
WATER COMM.

Warren

C10

MISSISSIPPI  
BOARD OF WATER COMMISSIONERS  
416 North State Street  
Jackson, Mississippi 39201

9-4-68

M.G.S.

WATER WELL DRILLERS LOG

CODED

9-4-68  
date well completed

19 David Benny  
firm name

Warren  
county well located

LANDOWNER: B.N. Simms

Description of formations encountered

from to

Redwood, Miss.

(mailing address)

WELL LOCATION: NE 1/4 SE 1/4

sec. 18 T. 18 N R. 5 E  
2 1/2 miles N of Redwood  
(distance) (direction) (nearest town)

WELL PURPOSE: home  
(home, irrigation, municipal, industrial)

WELL COMPLETION DATA:


- (1) diameter (inches) 4 X 2 1/2
- (2) total depth (feet) 1088
- (3) static water level (feet) 10 below top of ground.
- (4) casing BIK Pipe 1048 (material) (depth)  
4 X 2 1/2 (size) if telescope see back.
- (5) screen 40 1048 (length) (depth to top)  
2 1/2 STAINLESS (size) (material)
- (6) pump 2 (HP) (yield gpm)  
Elec. (type power)
- (7) electric log Yes (yes or no)  
Miss. Geo. (organization running log)
- (8) how well bottom plugged

Shale	0	20
Blue Shale	20	40
Blue fine sand	40	120
Light blue sand	120	240
Sand	240	420
Blue sand	420	460
Light blue sand	460	710
Sand	710	720
Hard Br. Shale	720	740
Shale	740	1000
Sand	1000	1088

CODED

DRILLERS REMARKS:

If well telescopes please sketch and show depths.

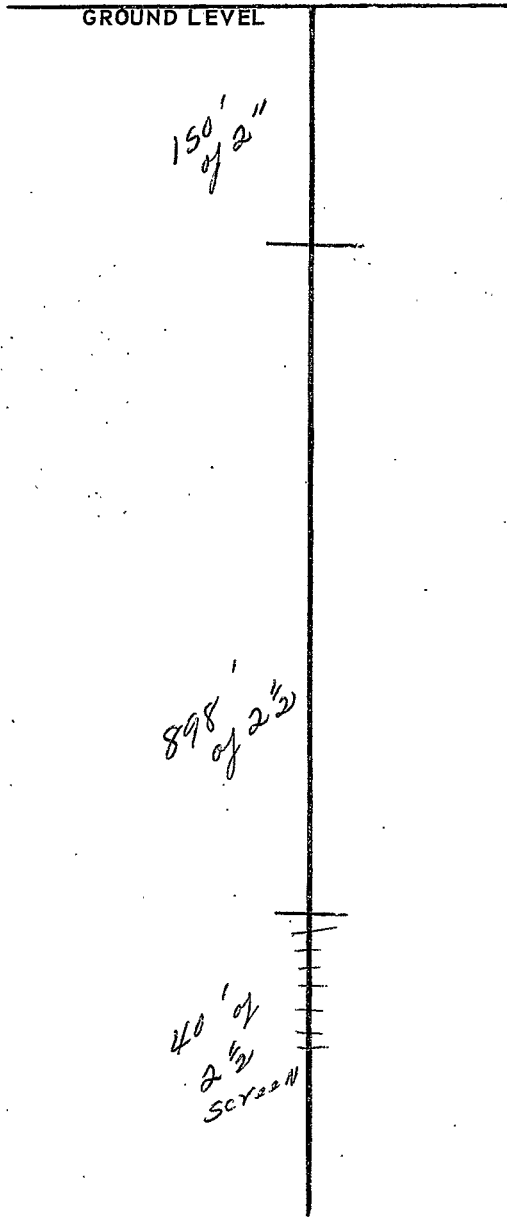


SECTION 18

Please indicate well location X.

ADDITIONAL INFORMATION

If more than one screen, show locations of each on sketch.