

**C. P. CLARK**  
**WATER WELL DRILLING**  
 ROUTE 2

MISSISSIPPI LAUREL, MISS. 39440  
 BOARD OF WATER COMMISSIONERS  
 416 North State Street  
 Jackson, Mississippi 39201

CODED

**WATER WELL DRILLERS LOG**

WARREN  
 C 11  
 7-68

7/29

1968

C. P. Clark

Warren

date well completed

firm name

county well located

LANDOWNER: Thomas Heam

description of formations encountered

from to

Pt #3

Wicksburg Miss  
 (mailing address)

Brown Clay	0'	85'
Wicksburg Sandstone	85'	135'
Sand & Gravel	135'	168'


WELL LOCATION:

sec. 29 T48N R 5E  
 S NE of Redwood  
 (distance) (direction) (nearest town)

WELL PURPOSE: Home  
 (home, irrigation, municipal, industrial)

WELL COMPLETION DATA:


- (1) diameter (inches) 2
- (2) total depth (feet) 168
- (3) static water level (feet) 151 below above top of ground.
- (4) casing Galv. Iron (material) (depth)
- 2 (size) if telescope see back.
- (5) screen 10" 158 (length) (depth to top)  
1 1/4" S.S. (size) (material)
- (6) pump 2 4 (HP) (yield gpm)  
220V Single P. (type power)
- (7) electric log no (yes or no)
- (organization running log)
- (8) how well bottom plugged B.W.V.

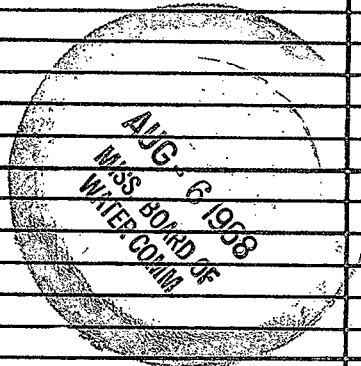

DRILLERS REMARKS:

If well telescopes please sketch and show depths.

GROUND LEVEL

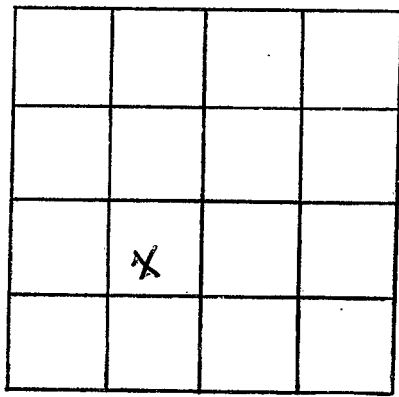

SECTION 29

Please indicate well location X.

ADDITIONAL INFORMATION

If more than one screen, show locations of each on sketch.