

Warren
 C 13
 12-18-69

MISSISSIPPI
 BOARD OF WATER COMMISSIONERS
 416 North State Street
 Jackson, Mississippi 39201

CODED
 CODED

WATER WELL DRILLERS LOG

12-18 1969 date well completed
 McConnell Drilling Co firm name
 Warren county well located


LANDOWNER:	description of formations encountered	from	to
Earnest H. Iderbrand Rt. 3 box 289 Vicksburg (mailing address)			
WELL LOCATION:			
sec. 28 T 18 N R 5 E 6 miles N of Oak Ridge (distance) (direction) (nearest town)			
WELL PURPOSE: Home (home, irrigation, municipal, industrial)			
WELL COMPLETION DATA:			
(1) diameter (inches) 4 X 2			
(2) total depth (feet) 156'			
(3) static water level (feet) 44' below top of ground			
(4) casing Steel, 146' (material) (depth) 4 X 2 if telescope see back. (size)			
(5) screen 10' length, 146' depth to top (size) (material) 2" stainless			
(6) pump 1/2 HP, 8 (yield gpm) Elec. (type power)			
(7) electric log No (yes or no) (organization running log)			
(8) how well bottom plugged Back Wash Valve			
DRILLERS REMARKS:			

DEC 22 1969

MISS. BD. OF
 WATER COMM.

If well telescopes please
sketch and show depths.

GROUND LEVEL

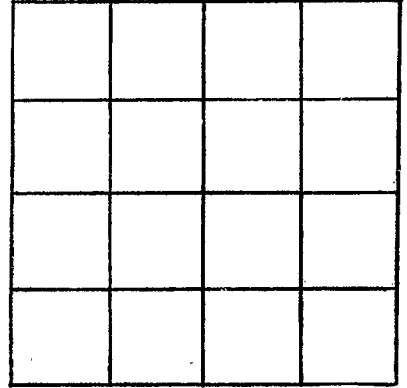

SECTION _____

Please indicate well location X.

ADDITIONAL INFORMATION

If more than one screen,
show locations of each on sketch.