

WARREN
C16
2-10-71

MISSISSIPPI
BOARD OF WATER COMMISSIONERS
416 North State Street
Jackson, Mississippi 39201

CODED

WATER WELL DRILLERS LOG

Feb-10 1971 W. E. M. "Bud" Besswell Warren
date well completed firm name county well located

LANDOWNER:
B. N. SIMRALL, FARMS, INC.
Redwood, Miss.
(mailing address)

description of formations encountered	from	to
Clay	0	120
Clay - Sand	120	230
Clay	230	720
Shaly - Sks sand	720	950
Shale	950	1035
Sand	1035	1060

WELL LOCATION:
sec. 18 T 18 N R 5 W
5 miles North of Redwood
(distance) (direction) (nearest town)

WELL PURPOSE: Domestic
(home, irrigation, municipal, industrial)

- WELL COMPLETION DATA:
- (1) diameter (inches) 2
 - (2) total depth (feet) 1060
 - (3) static water level (feet) 12 below above top of ground.
 - (4) casing Steel 1040
(material) (depth)
2 if telescope see back.
(size)
 - (5) screen 20 ft. 1040
(length) (depth to top)
2" stainless
(size) (material)
 - (6) pump 3/4 20
(HP) (yield gpm)
0
(type power)
 - (7) electric log No
(yes or no)
0
(organization running log)
 - (8) how well bottom plugged steel plug

CODED


FEB 22 1971

MISS. BD. OF
WATER COMM.

DRILLERS REMARKS:

If well telescopes please
sketch and show depths.

GROUND LEVEL

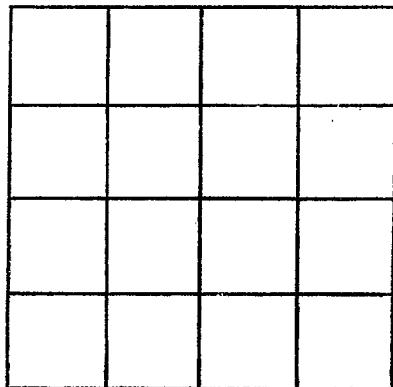

SECTION _____

Please indicate well location X.

ADDITIONAL INFORMATION

If more than one screen,
show locations of each on sketch.