

C 18
11-25-61

WATER WELL DRILLERS LOG

CODED

Date: 11-25-61 Driller: [Signature] County: [Signature]


(1) Owner of Land: J.B. Roberts
(Name)
Nicholas Miss
(Address)
(2) Location: 1/4, 1/4, Sec. 13 T. 18 R. 5
9 miles N of Oak
(distance) (direction) (Nearest Town)
(3) Topography: hilly ridge
(Hilly) (Flat) (Level)
(4) Purpose of Well: none
(Domestic, Irrigation, Municipal, Industrial, Other)

| Description & Color of Materials Sand, Clay, Red Clay, Shell, etc. | Thick- ness Feet | Depth Feet |
|---|------------------------|---------------|
| 0-105 clay | | |
| 105-127 sand | | |
| 127-135 sand | | |

Information upon completion of well:

(1) Diameter: 2 inches.
(2) Total Depth: 135 feet.
(3) Water Level: 101 feet below top of ground.
(4) Cased to: 135, Size: 2
(5) Screen: Size: 10/6, Length: 5'
(6) Were any formations sealed against pollution?
_____ yes, _____ no.

CODED

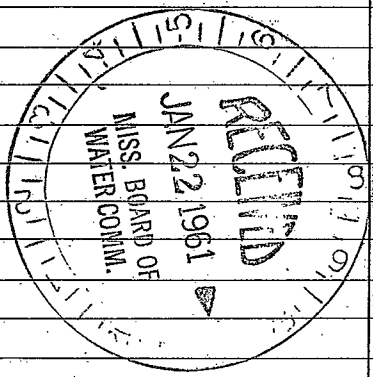

If YES depth of formation _____
Why _____
Drillers Remarks: _____

Well No.

(Use Back Side)

