

WARREN

C 19

6-10-71

MISSISSIPPI BOARD OF WATER COMMISSIONERS
416 North State Street
Jackson, Mississippi 39201

CODED

WATER WELL DRILLERS LOG

June 10 1971
date well completed

F.M. "Bud" Cresswell
firm name

Warren
county well located

LANDOWNER:

B.N. Simms & son
Redwood, Miss.
(mailing address)

description of formations encountered

from

to

Clay
Sand - gravel
0 25
25 89

WELL LOCATION:

sec. 18 T18 N R. 5 E
at full ground
miles of (distance) (direction) (nearest town)

WELL PURPOSE: domestic
(home, irrigation, municipal, industrial)

WELL COMPLETION DATA:

- (1) diameter (inches) 2
- (2) total depth (feet) 89
- (3) static water level (feet) 20 below top of ground
- (4) casing steel 84
(material) (depth)
2" if telescope see back.
(size)
- (5) screen 5" 84
(length) (depth to top)
2" stainless
(size) (material)
- (6) pump 7 1/2 5
(HP) (yield gpm)
10
(type power)
- (7) electric log No
(yes or no)
0
(organization running log)
- (8) how well bottom plugged steel plug

CODED


JUL 6 1971

DRILLERS REMARKS:

MISS. BD. OF WATER COMMISSIONERS

If well telescopes please sketch and show depths.

GROUND LEVEL

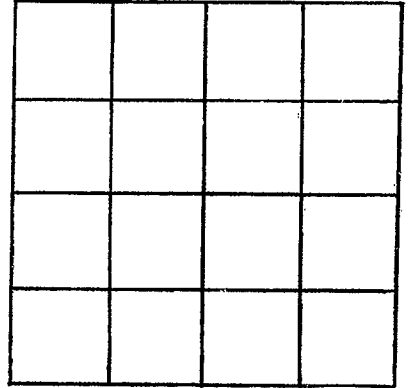

SECTION _____

Please indicate well location X.

ADDITIONAL INFORMATION

If more than one screen,
show locations of each on sketch.