

ELOG # 117

WARREN
C 20
1-31-73

MISSISSIPPI
BOARD OF WATER COMMISSIONERS
416 North State Street
Jackson, Mississippi 39201

CODED

WATER WELL DRILLERS LOG

1-31-1973 date well completed
JACK GWINN firm name
WARREN county well located

LANDOWNER: BROWN IS
(Barton)

(mailing address)

WELL LOCATION:
sec. 36 T. 9 N. R. 5 W.
10 miles W of HICKORY
(distance) (direction) (nearest town)

description of formations encountered	from	to
TOP SOIL	0	1
CLAY	1	30
SAND	30	40
CLAY	40	100
SAND	100	896

WELL PURPOSE:
(home, irrigation, municipal, industrial)

- WELL COMPLETION DATA:
- (1) diameter (inches) 2 1/2
 - (2) total depth (feet) 896
 - (3) static water level (feet) 3 below top of ground.
 - (4) casing TAC. 876
(material) (depth)
 - 2 1/2 (size) If telescope see back.
 - (5) screen 20 876
(length) (depth to top)
 - 2 1/2 (size) SS. (material)
 - (6) pump 1 (HP) 10 (yield gpm)
 - Rel. (type power)
 - (7) electric log RES.
(yes or no)
 - M. GS. (organization running log)
 - (8) how well bottom plugged Bro. V.

CODED


DRILLERS REMARKS:

AND BY

DATE

If well telescopes please
sketch and show depths.

GROUND LEVEL

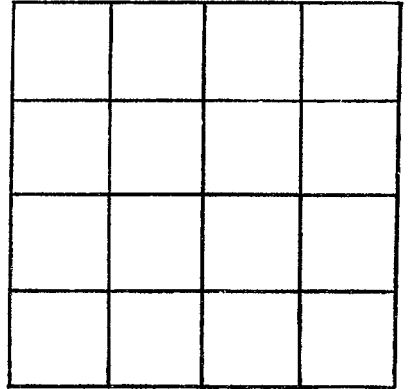

SECTION _____

Please indicate well location X.

ADDITIONAL INFORMATION

If more than one screen,
show locations of each on sketch.