

ELOG # 118

WARREN
C 21
3-8-73

MISSISSIPPI
BOARD OF WATER COMMISSIONERS
416 North State Street
Jackson, Mississippi 39201

CODED

WATER WELL DRILLERS LOG

3-8-1973 date well completed
JACK GUINN firm name
WARREN county well located

LANDOWNER: DAVIS, C.
(Carey)

description of formations encountered

from to

TOP SOIL 0 2
SAND 2 90
ROCK 90 96
CLAY 96 885
SAND 885 910

(mailing address)

WELL LOCATION:

sec. 35 T 9 N R 5 S
10 miles N of Wick.
(distance) (direction) (nearest town)

WELL PURPOSE:

(home, irrigation, municipal, industrial)

WELL COMPLETION DATA:

- (1) diameter (inches) 2"
- (2) total depth (feet) 910
- (3) static water level (feet) 8 below top of ground.
- (4) casing Tdc, 490 (material) (depth)
2" (size) if telescope see back.
- (5) screen 20' 490 (length) (depth to top)
2" (size) SS (material)
- (6) pump 1 (HP) 10 (yield gpm)
REH (type power)
- (7) electric log YES (yes or no)
M.G.S. (organization running log)
- (8) how well bottom plugged B.H.H.


CODED

DRILLERS REMARKS:

APR 11 7 1973

If well telescopes please sketch and show depths.

GROUND LEVEL

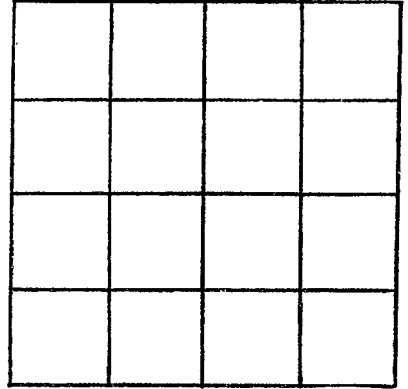

SECTION _____

Please indicate well location X.

ADDITIONAL INFORMATION

If more than one screen,
show locations of each on sketch.