

WARREN

C22

4-1-74

E log # 124

4-1

date well completed

MISSISSIPPI BOARD OF WATER COMMISSIONERS 416 North State Street Jackson, Mississippi 39201

WATER WELL DRILLERS LOG

CODED

1974 J. Frost Drilling Co. Warren

firm name

county well located

LANDOWNER:

Flarence Jenkins

Redwood Mills

Rt # 1 (mailing address)

WELL LOCATION:

sec 28 T 18 N R 5 E

5 miles north of Oak Ridge

WELL PURPOSE: home (home, irrigation, municipal, industrial)

WELL COMPLETION DATA:

- (1) diameter (inches) 2"
(2) total depth (feet) 185
(3) static water level (feet) 70 below top of ground.
(4) casing plastic 175 (material), (depth) 2" (size) if telescope see back.
(5) screen 10 ft 175 (length), (depth to top) 2" (size), PVC plastic (material)
(6) pump 2 (HP) 15 (yield gpm) AC (type power)
(7) electric log yes (yes or no) M. P. S. (organization running log)
(8) how well bottom plugged backwash tray

description of formations encountered


from

to

Clay 0 60
sand 60 80
shale 80 175
sand 175 185


CODED

DRILLERS REMARKS:

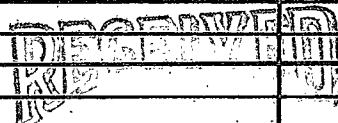

If well telescopes please sketch and show depths.

GROUND LEVEL

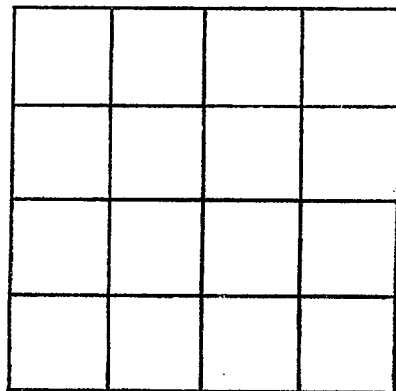

SECTION _____

Please indicate well location X.

ADDITIONAL INFORMATION

A series of horizontal lines for entering additional information, starting below the 'ADDITIONAL INFORMATION' header.

If more than one screen, show locations of each on sketch.