

**WARREN**  
**C23**  
**1-5-74**

MISSISSIPPI  
 BOARD OF WATER COMMISSIONERS  
 416 North State Street  
 Jackson, Mississippi 39201

**CODED**

**WATER WELL DRILLERS LOG**

1-5- 1974 JEPcoat Drilling Co. WARREN  
 date well completed firm name county well located

**LANDOWNER:**  
Mr. Robert Tisdale  
116 Resks St. Vicksburg.  
 (mailing address)

description of formations encountered	from	to
CLAY top soil	0	70
SAND	70	80
SHALE	80	190
Rock Limestone	190	238
SHALE	238	250
SAND	250	277
		T. D.

**WELL LOCATION:**  
 sec. 4 T. 18 (N) R. 5 (E)  
 S old school  
1/2 miles S of oak Ridge  
 (distance) (direction) (nearest town)

**WELL PURPOSE:**  
 (home, irrigation, municipal, industrial)

**CODED**

**WELL COMPLETION DATA:**

(1) diameter (inches) 4"

(2) total depth (feet) 275

(3) static water level (feet) 159 below top of ground.

(4) casing P.V.C. 260,  
 (material) (depth)  
4" if telescope see back.  
 (size)

(5) screen 15' 260  
 (length) (depth to top)  
4" P.V.C.  
 (size) (material)


(6) pump 1 15  
 (HP) (yield gpm)  
Electric  
 (type power)

(7) electric log NO -  
 (yes or no)

(organization running log)

(8) how well bottom plugged Sand  
shank


**DRILLERS REMARKS:**

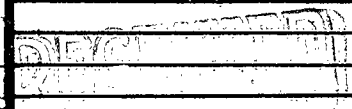

ADD 1 0 18/74

If well telescopes please  
sketch and show depths.

GROUND LEVEL

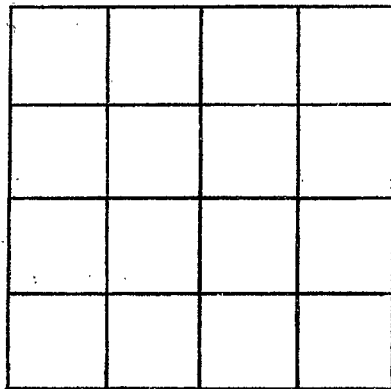

SECTION \_\_\_\_\_

Please indicate well location X.

ADDITIONAL INFORMATION

If more than one screen,  
show locations of each on sketch.