

MISSISSIPPI DEPARTMENT OF NATURAL RESOURCES

Bureau of Land and Water Resources

Southport Mall

P.O. Box 10631

Jackson, Mississippi 39209

WATER WELL DRILLERS LOG **CODED**

Griner Drilling Service, INC.

Warren

WARREN
E 26
10-13-85

10-13-85 date well completed *Griner Drilling Service, INC.* firm name *Warren* county well located

LANDOWNER:	description of formations encountered	from	to
<i>Ultramar Oil & Gas</i> <i>16825 Northchase Dr.</i> <i>Suite 1200</i> <i>Houston, Texas 77060</i> <small>(mailing address)</small>	<i>Fill-gravel</i>	<i>0</i>	<i>105</i>
WELL LOCATION: <i>2039' N & 1791' W</i> sec. <i>22 T 18 N R 5 E</i> of <i>Redwood</i> SE/4 of <i>Redwood</i> <small>(distance) miles (direction) of (nearest town)</small>	<i>chalk</i>	<i>105</i>	<i>550</i>
WELL PURPOSE: <i>oilfield supply</i> <small>(home, irrigation, municipal, industrial)</small>	<i>clay</i>	<i>550</i>	<i>820</i>
WELL COMPLETION DATA:	<i>shale, sand</i>	<i>820</i>	<i>1050</i>
(1) diameter (inches) <i>3"</i>	<i>shale-</i>	<i>1050</i>	<i>1113</i>
(2) total depth (feet) <i>1302'</i>	<i>sand</i>	<i>1113</i>	<i>1218</i>
(3) static water level (feet) <i>225' below</i> <small>above top of ground.</small>	<i>clay</i>	<i>1218</i>	<i>1302</i>
(4) casing <i>steel, 1218'</i> <small>(material) (depth)</small> <i>3"</i> <small>(size) if telescope see back.</small>			
(5) screen <i>105', 1113'</i> <small>(length) (depth to top)</small> <i>3" perforated</i> <small>(size) (material)</small>			
(6) pump <i>— 60</i> <small>(HP) (yield gpm)</small> <i>AC</i> <small>(type power)</small>			
(7) electric log <i>yes</i> <small>(yes or no)</small> <small>(organization running log)</small>			
(8) how well bottom plugged <i>Orange peel</i>			
DRILLERS REMARKS:			


RECEIVED

NOV -1 1985

Department of Natural Resources
Bureau of Land & Water Resources

If well telescopes please
sketch and show depths.

GROUND LEVEL

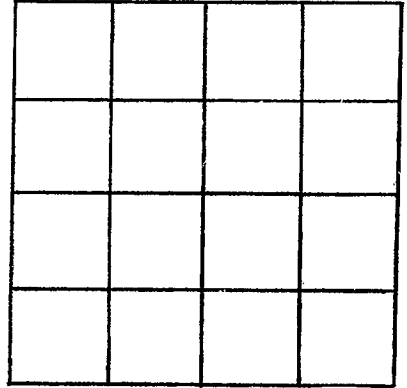

SECTION _____

Please indicate well location X.

ADDITIONAL INFORMATION

If more than one screen,
show locations of each on sketch.