

**MISSISSIPPI DEPARTMENT OF ENVIRONMENTAL QUALITY**

Office of Land and Water Resources

P. O. Box 10631  
Jackson, MS 39289-0631  
**WATER WELL DRILLERS LOG**

COUNTY WELL LOCATED <i>Warren</i>	
WELL NUMBER <i>C2001</i>	CODED
DATE WELL COMPLETED <i>5-29-95</i>	

PERMIT NUMBER
NAME OF DRILLING FIRM <i>Arnold Fincher Sr</i>

NAME & MAILING ADDRESS OF LANDOWNER <i>John Magliocco</i>		
<i>17370 oak Ridgerd</i>		
<i>Vicksburg, MS</i>		
WELL LOCATION: SEC	TOWNSHIP	RANGE
<i>13</i>	<i>18</i>	<i>5</i>
	<i>N</i>	<i>E</i>
	<i>S</i>	<i>W</i>
DISTANCE	DIRECTION	NEAREST TOWN
<i>15</i> Miles	<i>NE</i>	of <i>Vicksburg</i>
OTHER LANDMARK		
WELL PURPOSE: Home, Irrigation, Municipal, Industrial, Fish Pond, etc. <i>Home</i>		

PUMP DATA		
PUMP TYPE (Circle One): <input checked="" type="radio"/> Submersible, Turbine, Jet, Flowing Well, Other (Describe) _____		
POWER TYPE (Circle One): <input checked="" type="radio"/> Electric, Tractor, Diesel, Gasoline, Butane, Other (Describe) _____ H/P _____		
Pump Capacity (GPM) <i>10</i>	No. of Stages <i>8</i>	Setting Depth <i>125</i> FT.
PUMP TEST		
Well yielded <i>10</i> GPM with a drawdown of <i>30</i> ft. after <i>24</i> hours of pumping		

WELL DATA		
Well Depth <i>135</i>	Casing Diameter (In.) <i>4</i>	Casing Length (Ft.) <i>115</i>
Type of Casing <i>PUC</i>	Hole Depth <i>135</i>	Depth to Static Water Level <i>80</i>
TYPE OF COMPLETION: (Circle One or More): <input checked="" type="checkbox"/> Gravel Packed, Underreamed, Telescoped, <input checked="" type="checkbox"/> Natural Development, Open Hole, Other (Describe) _____		
WELL GROUTED TO A DEPTH OF <i>10</i> FEET Type Grout (circle one): Cement, Bentonite, or Mix		

LOG DATA	
TYPE OF LOG RUN (Circle One): <input checked="" type="radio"/> No Log Run, Electric, Gamma Ray, Density, Sonic, Neutron, Other (Describe) _____	
Name of Organization Running Log	

SCREEN DATA		
Diameter - Inches <i>4</i>	Length - Feet <i>20</i>	Slot Size - Inches <i>.008</i>
Screen Type <i>PUC</i>	Depth to Bottom - Feet <i>135</i>	


GEOLOGIC DATA (Office Use Only)			
Surface Elev.	Geologic Unit	Unit Thickness	Depth to Top
Subs: SWL	Date	Analysis	Aquifer Test
Driller's Remarks			
Top of Lap Pipe or Reduction in Casing			
FEET		IF TELESCOPED OR MORE THAN ONE SCREEN: USE BACK PAGE	

DESCRIPTION OF FORMATIONS ENCOUNTERED	FROM	TO
<i>Brown Clay</i>	<i>0</i>	<i>105</i>
<i>Course Sand</i>	<i>105</i>	<i>135</i>
<i>Rock</i>	<i>135</i>	<i>-</i>

FORMATIONS (Continued)	FROM	TO
<b>RECEIVED</b>		
<b>JUN 01 1995</b>		
Dept. of Environmental Quality Office of Land & Water Resources		
IF MORE SPACE IS NEEDED, USE BACK		

If well telescopes please  
sketch and show depths.

GROUND LEVEL

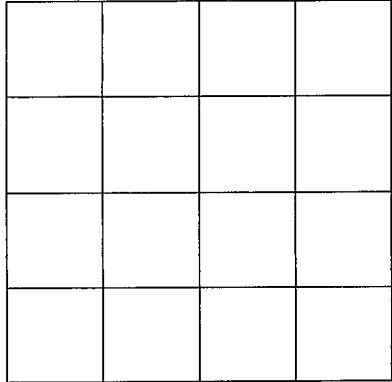

SECTION \_\_\_\_\_

Please indicate well location X.

ADDITIONAL INFORMATION

If more than one screen,  
show location of each on sketch.