

WARREN
E10
10-16-71

MISSISSIPPI
 BOARD OF WATER COMMISSIONERS
 416 North State Street
 Jackson, Mississippi 39201

CODED

WATER WELL DRILLERS LOG

1971 E. Mc "Bud" Cresswell WARREN
 firm name county well located

Oct-16
 date well completed

LANDOWNER:
Lum Cattle Co.
Vicksburg, Miss.
 (mailing address)

description of formations encountered	from	to
<u>Clay</u>	<u>0</u>	<u>40</u>
<u>Sand-gravel</u>	<u>40</u>	<u>89</u>

WELL LOCATION:
 sec. 15 T. 17 N. R. 3 E
8 miles west of Vicksburg
 (distance) (direction) (nearest town)

WELL PURPOSE: Stock
 (home, irrigation, municipal, industrial)

- WELL COMPLETION DATA:
- (1) diameter (inches) 2
 - (2) total depth (feet) 89
 - (3) static water level (feet) 25 below top of ground.
 - (4) casing steel, 84 (material) (depth)
2" if telescope see back. (size)
 - (5) screen 5ft., 84ft. (length) (depth to top)
2" (size) stainless (material)
 - (6) pump 3/4 (HP) 10 (yield gpm)
0 (type power)
 - (7) electric log No (yes or no)
- (organization running log)

CODED


DRILLERS REMARKS:

NOV 12 1971

MISS. BD. OF
 WATER COMM.

If well telescopes please sketch and show depths.

GROUND LEVEL

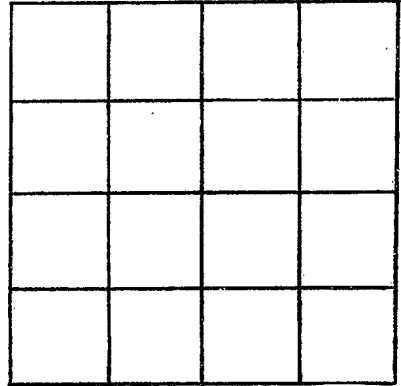

SECTION _____

Please indicate well location X.

ADDITIONAL INFORMATION

If more than one screen, show locations of each on sketch.