

**WARREN**  
**E 13**  
**5-17-74**

MISSISSIPPI  
 BOARD OF WATER COMMISSIONERS  
 416 North State Street  
 Jackson, Mississippi 39201


**CODED**

**WATER WELL DRILLERS LOG**

May 17 1974 E.M. "Bud" Cresswell Warren  
 date well completed firm name county well located

LANDOWNER:	description of formations encountered	from	to
<u>Lombard Burns</u> <u>Vicksburg, Miss.</u> (mailing address)		<u>Clay</u> <u>Sand</u>	<u>8</u> <u>15</u>
WELL LOCATION: sec. <u>12</u> T. <u>17</u> N. R. <u>3</u> E <u>3</u> miles <u>North</u> of <u>Vicksburg</u> (distance) (direction) (nearest town)			
WELL PURPOSE: <u>Home</u> (home, irrigation, municipal, industrial)			
WELL COMPLETION DATA:			
(1) diameter (inches) <u>2</u>			
(2) total depth (feet) <u>60</u>			
(3) static water level (feet) <u>10</u> below top of ground.			
(4) casing <u>Steel</u> , <u>55</u> (material), (depth) <u>2</u> if telescope see back. (size)			
(5) screen <u>5</u> , <u>55</u> (length), (depth to top) <u>2</u> , <u>Stainless</u> (size), (material)			
(6) pump <u>3/4</u> , <u>10</u> (HP), (yield gpm) <u>0</u> (type power)			
(7) electric log <u>0</u> (yes or no) <u>0</u> (organization running log)			
(8) how well bottom plugged <u>Set Plug</u>			
DRILLERS REMARKS:			


**CODED**

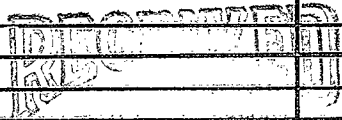

MAY 21 1974

If well telescopes please  
sketch and show depths.

GROUND LEVEL

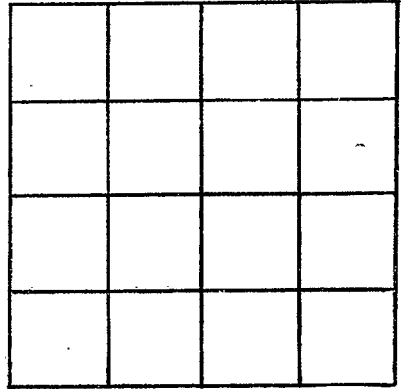

SECTION \_\_\_\_\_

Please indicate well location X.

ADDITIONAL INFORMATION

If more than one screen,  
show locations of each on sketch.