

WARREN  
E 17  
10-3-81

MISSISSIPPI DEPARTMENT OF NATURAL RESOURCES  
Bureau of Land and Water Resources  
Southport Mall  
P.O. Box 10631  
Jackson, Mississippi 39209  
WATER WELL DRILLERS LOG

CODED

10-3 1981 Rayburn Drill & Const. Co. Warren  
date well completed firm name county well located

LANDOWNER:	description of formations encountered	from	to
Transcontinental oil Co. Shreveport, La (mailing address)	Top soil Gumbo Sand	0 2 12	2 12 90
WELL LOCATION: sec. 20 T 17 N S R 3 E W			
(distance) miles of (direction) (nearest town)	(Could not locate in Oil Review)		
WELL PURPOSE: (home, irrigation, municipal, industrial)			
WELL COMPLETION DATA:			
(1) diameter (inches) 3"			
(2) total depth (feet) 90'			
(3) static water level (feet) 25' below top of ground.			
(4) casing (material) Blk (depth) 70'			
3" (size) if telescope see back.			
(5) screen (length) 30' (depth to top) 70'			
3" (size) Blk Slotted Pipe (material)			
(6) pump (HP) 42 GPM (yield gpm)			
(type power)			
(7) electric log (yes or no) no			
(organization running log)			
(8) how well bottom plugged Wood Plug			


CODED

Rec'd L & W  
10-21-81

DRILLERS REMARKS:

If well telescopes please sketch and show depths.

GROUND LEVEL

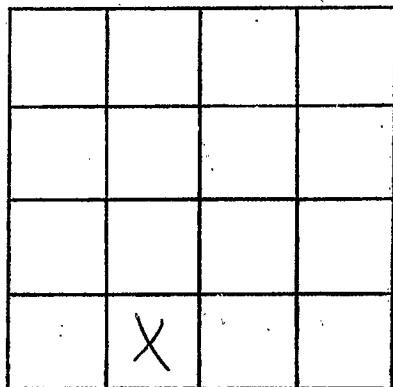

SECTION 20

Please indicate well location X.

ADDITIONAL INFORMATION

If more than one screen,  
show locations of each on sketch.