	Well Driller Report and Well Log	For Office Use Only:
County: <u>Warren</u> Permit # : <u>GW - /6070</u> Driller: <u>J. E. Smith, Jr.</u>	Mississippi Department of Environmental Quality Office of Land and Water Resources P.O. Box 10631 Jackson, MS 39289-0631 (601) 961-5210 (601) 354-6938 (fax)	Aquifer:
Date drilling completed:4/4/2005	(001) 334-6936 (187)	E-Log # :

State Law requires that this report be prepared by the driller in detail and filed with the Department within 30 days of completion of drilling of the well.

, "

4. •

.


Well Owner Information	Well Location				
	• • • • • • • • • • • • • • • • • • •				
wner Name City of Vicksburg #13					
ailing Address:	Method of Lat/Long (circle one): Conventional Survey,				
P.O. Drawer 150	USGS quad, Hand-held GPS, Survey-grade GPS				
Vicksburg MS 3918	0 SE 1/4 SW 1/4 Sec <u>13</u> Twn <u>17N</u> Rng <u>3 E</u>				
City State Zip Code	Distance Direction Nearest Town 0 Miles north of vicksburg				
elephone No601 631-8800					
Well Data					
urpose of Well (circle one) Home Industrial (Public Su	oply) Irrigation Fish Culture Other:				
ate well drilling started:3/15/2005	Date well drilling completed: 4-4-05				
flowing, method of flow regulation: Valve	Other (describe)				
tatic Water Level: <u>9.20</u> feet above or (below) (circle	one) land surface Date measured: 4/4/2005				
lethod of Measurement (circle one) steel tape (electric tap	e) air line other:				
lole depth:145' Well depth:145'	Well grouted to a depth of95' feet				
ype of grout (circle one) Cement Bentonite (Mix)					
	The state Steel				
Casing length:95_feet Casing diameter	36 inches Type of casing: Steel				
Screen length:40 feet Screen diameter	20_inches Type of screen: Rod Base				
creen slot size 0.03 inches Setting depth: Fro	m <u>105</u> feet to <u>145</u> feet				
Type of completion (circle all applicable): (Gravel packed) (Ur	derreamed) Telescoped Open hole Natural development				
Other (describe):					
	escoped or more than one screen, describe on back of page				
rop of lap pipe or reduction in casing:5feet. If te	escoped of more main one screen, accorded on allow of page				
ogs run (circle all applicable): No log run (Electric) (Gamma R	ay) Density Sonic Neutron Other:				
Name of organization running log(s): Griner Drilling Service					
certify that the well was drilled, constructed, and completed in accorda	nce with all applicable requirements of the Mississippi Department of				
invironmental Quality and/or the Mississippi Department of Health regul	ations and state laws.				
Criner Drilling Service Inc. 0,581	Chal-H. /2-511				
Giner Drilling Service, Inc. 0-581 Frint Name of Water Well Contractor and License No.	Signature of Water Well Contractor				
If well telescopes please sketch below and show depths	TUL 15 c				
	SY OLV				

8-29

Description of Formations Encountered		То
 Clay	0	40
Sand	40	150
Clay	150	163
· · · · · · · · · · · · · · · · · · ·		
		<u> </u>
1		

If more than one screen, show location of each on sketch

Ground Level

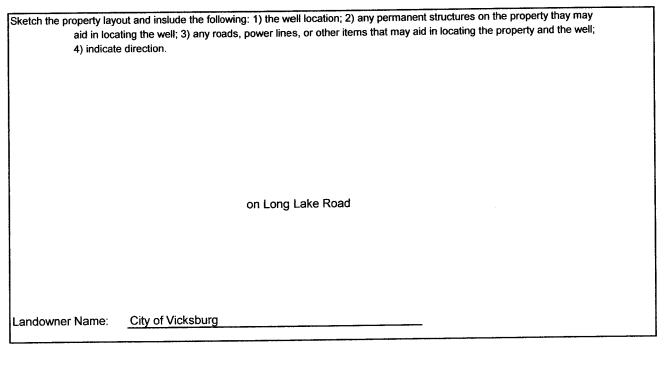

LA Signature of Water Well Contractor

- 現代が生 超や1010年末

STATE	WELL	REPORT
	Part 2	

County:	Warren	
Permit # :		
Driller:	J. E. Smith, Jr.	
Date Completed	l:	6/30/2005
1		

ĩ

Pump Installer's Completion Report

Mississippi Department of Environmental Quality Office of Land and Water Resources P.O. Box 10631 Jackson, MS 39289-0631 (601)961-5210 (601)354-6938 (fax)

For Office Use Only:	
Aquifer: Nell # : <u>E-29</u>	
Elevation:	

This report must be prepared by the pump installer in detail and filed with the Department with 30 days of the installation of pump. A copy of Part 1 of this report must be attached to the report.

Well Owner Information				Well Location					
Owner Name City of Vicksburg #13 I				Latitude:			Longitu	ıde:	
Mailing Address:				Method of Lat/Long (circle one): Conventional Survey,					
P.O. Drawer 150			USGS quad, Hand-held GPS, Survey-grade GPS						
	Vicksburg	MS		39180	SE	1/4	SW	1/4 Sec _	<u>13</u> Twn <u>17 N</u> Rng <u>3 E</u>
	City	State	Zip Code		Distance		Direction		Nearest Town
Telephone No.	601-631-8800		_		0	Miles	north	of	Vicksburg

Pump Type Circle one				Power Type Circle one			
Air Lift	Jet		Submersible	Diesel Engine	Gasoline Engine	Natural Gas	
Bucket	Piton		(Turbine)	(Electric Motor)	Hand	Tractor PTO	
Centrifugal	Rotary		Flowing Well	Windmill	Other (specify):		
Other (specify)	:			Horse Power Ratin	g of Motor:	75	
Date Pump ins	talled:	5/24/2005		Setting Depth:		90 feet	
 Rated Pump C	apacity:	1000	Gallons per minute	Number of Stages:		3	

	Pump Test Data		Method of Measuring Water Level			
			Circle One			
Date Well Tested:	3/31/2005			(Electric Measuring Line)	Steel Tape	
	0.0	Feet Below Land Surface	Air Line	(Electric Measuring Line)	Greet Tupo	
Static Water Level (A):	9.2	-	Other (specify) :			
Pumping Water Level (B)	22.74	_Feet Below Land Surface	G u (op, y)			
		_			<i>.</i> .	
Drawdown {(B) - (A)} :	13.54	_Feet Below Land Surface	For flowing well,	measured shut in head :	feet	
Test Pumping Rate:	1001	Gallons Per Minute	Well yielded	GPM with a draw	wdown of	
		_				
Duration of Pump test (mi	nimum 4 hours) :	_24 hours	13.54	feet after 24	hours of pumping	
			1			

 I HEREBY CERTIFY that the above statements are true to the best of my knowledge.

 Griner Drilling Service, Inc. 0-581

 Print Name of Pump Installer and License No. (if applicable)

 Signature of Pump Installer

 RECEIVED

JUL 192006 BY OLIVER