

CDLSPMHW - PROST

State Well Report

Part 1 - Driller's Log

Mississippi Department of Environmental Quality
Office of Land and Water Resources
P.O. Box 2309
Jacksen, MS 39226
(601)961-5210
(601)961-5228 (fax)

County: Warren
 Permit: GW-16972
 Driller: J. NEWCOMB 0-773
 Date drilling completed: 6-11-2012

For Office Use Only:
 Aquifer: _____
 Well #: E-32
 L. S. Elevation: _____
 E-log #: _____

State Law requires that this report be prepared by the license holder responsible for the work and filed with the Department at the above address within 30 days of completion of drilling of the well or borehole.

Information on Well Owner (Landowner if borehole is not for a water well) Owner Name: <u>Strick's Harvesting LLC</u> Mailing Addr: <u>395 Chapel Hills Dr</u> <u>Vicksburg MS 39180</u> City State Zip Code Telephone No. () _____	Well or Borehole Location Latitude: <u>32.25.41</u> Longitude: <u>90.51.56</u> Method of Lat/Long (circle one): Conventional Survey, USGS quad, <u>Hand-held GPS</u> , Survey-grade GPS <u>SW</u> 1/4 <u>SE</u> 1/4 Sec <u>11</u> Twn <u>17N</u> Rng <u>3E</u> Distance Direction Nearest Town <u>3</u> Miles <u>N</u> of <u>VICKSBURG</u>
--	---

Well / Borehole Data

Date drilling started: 6-11-12 Date drilling completed: 6-11-12 Hole depth: 132 Hole diameter: 24"

Location of the source of any surface water used for drilling: DITCH

Method of dosing and volume of Chlorine used in drilling and development: CHLORINE TABLETS

Logs run (circle all applicable): No log run Electric Gamma Ray Density Sonic Neutron Other: _____

Name of organization running logs: _____

Purpose of borehole (check one): Water Well Geotechnical/Geological Investigation _____ Ground Source Heat Pump _____

Seismic Survey _____ Other (describe) _____

If drilling is not related to water well construction, skip the remainder of this block

Purpose of Well (check one): Home _____ Industrial _____ Public Supply _____ Irrigation Fish Culture _____ Other: _____

If a flowing well, method of flow regulation: Valve _____ Other (describe) _____

Static Water Level: _____ feet above or below (circle one) land surface Date measured: _____

Method of Measurement (circle one) steel tape electric tape air line other: _____

Well depth: 130 Well grouted to a depth of 10 feet Type of grout (circle one): Neat Cement Bentonite Mix

Casing length: 90 feet Casing diameter: 16 inches Type of casing: P.V.C.

Screen length: 40 feet Screen diameter: 16 inches Type of screen: P.V.C.


Screen slot size: .050 inches Setting depth: From 90 feet to 130 feet

Type of completion (circle all applicable): Gravel packed Underreamed Telescoped Open hole Natural Development

Other (describe): _____


Top of lap pipe or reduction in casing: _____ feet. *If telescoped or more than one screen, describe on next page*

Form: OLWR-SWR-1A (04/08)

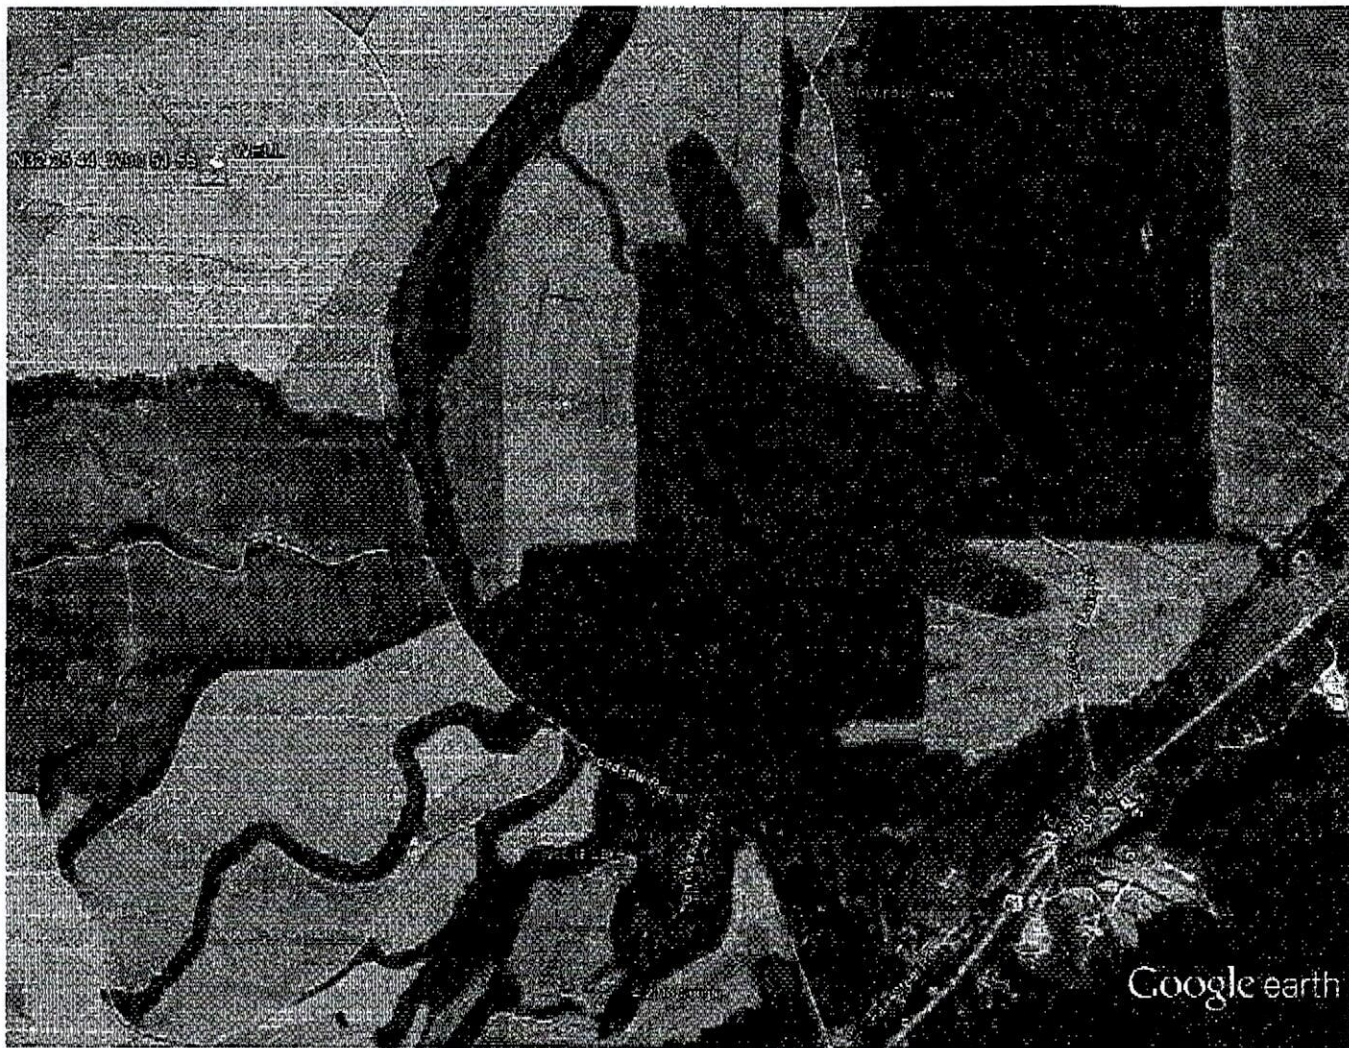

TO:
New
61

Google earth

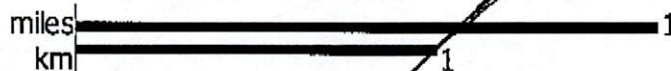

TO
VIKSBURG

