

E

WATER WELL DRILLERS LOG

301

6-16-61

Date: 6/16, 1961; Driller: D.H. Williams County Warren

(Name)

(1) Owner of Land: Spencer Chemical Co
 (Name)
Vicksburg Miss
 (Address)
Long Lake Club =
 (2) Location: 1/4, 1/4, Sec. T R,
1 1/2 miles north west, Waltersville
1 1/2 miles n/w, of Waltersville
 (distance) (direction) (Nearest Town)

(3) Topography: Flat
 (Hilly) (Flat) (Level)

(4) Purpose of Well: Recreation
 (Domestic Irrigation
 Municipal, Industrial, Other)

Description & Color of Materials Sand, Clay, Red Clay, Shell, etc.	Thick- ness Feet	Depth Feet
<u>Block surface Grumbo</u>	<u>35</u>	<u>35</u>
<u>Black silt + Fine Sand</u>	<u>30</u>	<u>65</u>
<u>3 feet Hard Grumbo or shale</u>	<u>3</u>	<u>68</u>
<u>Sand, Grey + mixed =</u>		
<u>Black slate like Castings</u>		
	<u>25</u>	<u>93</u>
<u>Red Sand</u>	<u>5</u>	<u>103</u>
<u>22ft Grey Sand + Gravel</u>	<u>22</u>	<u>125</u>

Information upon completion of well:

(1) Diameter 4 1/2 inches.

(2) Total Depth 125ft feet.

(3) Water Level 30ft feet below top of ground.


(4) Cased to 94, Size 2"

(5) Screen: Size 2", Length 10ft

(6) Were any formations sealed against pollution?
 yes, no.

If YES depth of formation 12ft to
Top - Keep Water Seepage
 Why out of well from Top Ground

Drillers Remarks:
1/2 HP Jet Pump used
Recovered 10 bar per minute

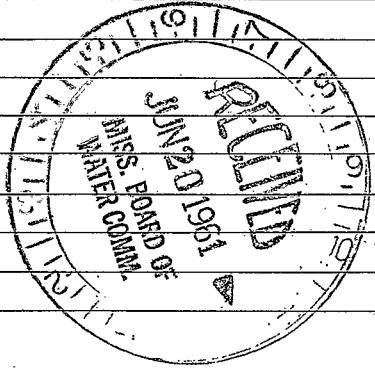

(Use Back Side)

Well No.

