

WARREN  
E 2000  
6-10-77

MISSISSIPPI  
BOARD OF WATER COMMISSIONERS  
416 North State Street  
15J Jackson, Mississippi 39201

WATER WELL DRILLERS LOG

June 10 1977 E.M. "Bud" Cresswell Warren  
date well completed firm name county well located

LANDOWNER:  
Robert E. Martin  
Vicksburg, Ms.  
(mailing address)

description of formations encountered	from	to
Clay sand - gravel	0	20
	20	120

WELL LOCATION:  
sec. 13 T 17 N R 3 E  
3 miles N of Vicksburg  
(distance) (direction) (nearest town)

WELL PURPOSE: home  
(home, irrigation, municipal, industrial)

- WELL COMPLETION DATA:
- (1) diameter (inches) 4
  - (2) total depth (feet) 120
  - (3) static water level (feet) 20 below top of ground.
  - (4) casing PVC 110  
(material) (depth)  
4 If telescope see back.  
(size)
  - (5) screen 10 110  
(length) (depth to top)  
4 PVC  
(size) (material)
  - (6) pump 1 25  
(HP) (yield gpm)  
0
  - (7) electric log no  
(yes or no)  
0  
(organization running log)

(8) how well bottom plugged?  
Steel plug


DRILLERS REMARKS:

RECEIVED  
JUN 20 1977

MISS. BD. OF WATER COMMISSIONERS

If well telescopes please sketch and show depths.

GROUND LEVEL

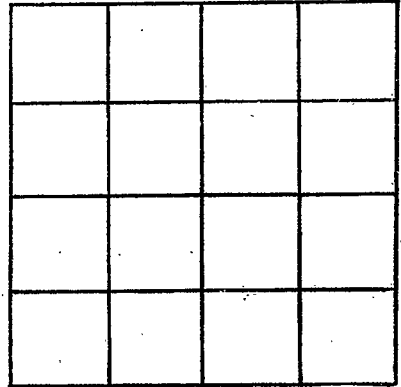

SECTION \_\_\_\_\_

Please indicate well location X.

ADDITIONAL INFORMATION

If more than one screen, show locations of each on sketch.