

WARREN

MISSISSIPPI DEPARTMENT OF NATURAL RESOURCES
Bureau of Land and Water Resources
Southport Mall
P.O. Box 10631
Jackson, Mississippi 39209
WATER WELL DRILLERS LOG

F 2001
7-18-80

July 18 1980 E.M. "Bud" Cresswell Warren
date well completed firm name county well located


LANDOWNER:	description of formations encountered	from	to
Wayne Heard Redwood, Ms. (mailing address)	Clay Sand gravel	0	40 130
WELL LOCATION: sec 23 T 18 N R 3 E 5 miles N of Vicksburg (distance) (direction) (nearest town)			
WELL PURPOSE: <u>Horse</u> (home, irrigation, municipal, industrial)			
WELL COMPLETION DATA:			
(1) diameter (inches) <u>2</u>			
(2) total depth (feet) <u>130</u>			
(3) static water level (feet) <u>18</u> below top of ground.			
(4) casing <u>PVC</u> , <u>120</u> (material) (depth)			
<u>2</u> if telescope see back. (size)			
(5) screen <u>10</u> , <u>120</u> (length) (depth to top)			
<u>2</u> , <u>PVC</u> (size) (material)			
(6) pump <u>None</u> , <u>20</u> (HP) (yield gpm)			
(type power)			
(7) electric log <u>No</u> (yes or no)			
(organization running log)			
(8) how well bottom plugged <u>Sand - Shale</u>			
DRILLERS REMARKS:			

DEPT. OF NATURAL RESOURCES
BUREAU OF LAND & WATER RESOURCES

JUL 29 1980
RECEIVED

If well telescopes please
sketch and show depths.

GROUND LEVEL

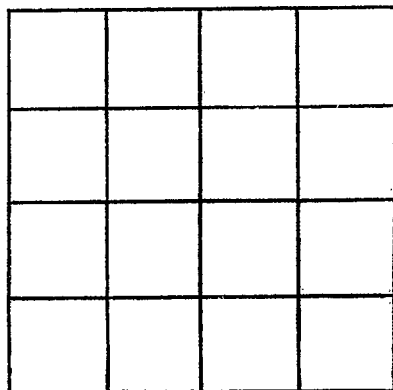

SECTION _____

Please indicate well location X.

ADDITIONAL INFORMATION

If more than one screen,
show locations of each on sketch.