

MISSISSIPPI DEPARTMENT OF NATURAL RESOURCES

Bureau of Land and Water Resources

Southport Mall

P.O. Box 10631

Jackson, Mississippi 39209

WATER WELL DRILLERS LOG

Warren  
E 3002

Oct. 24 1983 B.E.M. Bud Cresswell Warren  
date well completed firm name county well located

LANDOWNER:	description of formations encountered	from	to
Odis Hunt	Clay	0	30
Vicksburg, MS. (mailing address)	Sand-gravel	30	120
<b>WELL LOCATION:</b> sec. 20 T 21 N R 3 E 5 miles West of Vicksburg (distance) (direction) (nearest town)			
<b>WELL PURPOSE:</b> Home (home, irrigation, municipal, industrial)			
<b>WELL COMPLETION DATA:</b>			
(1) diameter (inches) 2			
(2) total depth (feet) 120			
(3) static water level (feet) 27 below top of ground.			
(4) casing PVC 110 (material) (depth)			
2 (size) if telescope see back.			
(5) screen 10 110 (length) (depth to top)			
2 PVC (size) (material)			
(6) pump 1 10 (HP) (yield gpm)			
(type power)			
(7) electric log No. (yes or no)			
(organization running log)			
(8) how well bottom plugged Back wash valve			
DRILLERS REMARKS:			


DEPT. OF NATURAL RESOURCES  
BUREAU OF LAND & WATER RESOURCES

NOV 23 1983

RECEIVED

If well telescopes please sketch and show depths.

GROUND LEVEL

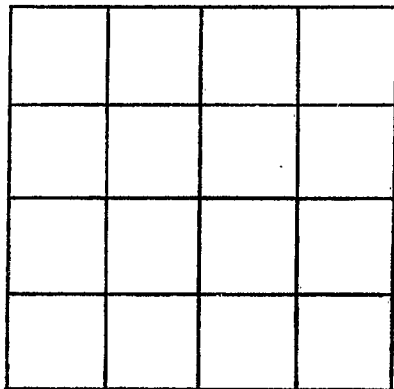

SECTION \_\_\_\_\_

Please indicate well location X.

ADDITIONAL INFORMATION

If more than one screen,  
show locations of each on sketch.