

MISSISSIPPI DEPARTMENT OF NATURAL RESOURCES  
 Bureau of Land and Water Resources  
 Southport Mall  
 P.O. Box 10631  
 Jackson, Mississippi 39209  
**WATER WELL DRILLERS LOG**

Warren  
E 2003

Sept. 4 - 1984 E. M. Bud Cresswell Warren  
 date well completed firm name county well located

LANDOWNER:  
10 Back Hunting Club  
Redwood, Ms.  
 (mailing address)

description of formations encountered	from	to
	<u>Clay</u>	<u>0</u>
<u>Sand - gravel</u>	<u>40</u>	<u>110</u>

WELL LOCATION:  
 sec 20 T 17 N R 3 E  
8 miles West of Redwood  
 (distance) (direction) (nearest town)

WELL PURPOSE: Camp  
 (home, irrigation, municipal, industrial)


- WELL COMPLETION DATA:
- (1) diameter (inches) 4
  - (2) total depth (feet) 110
  - (3) static water level (feet) 15 below top of ground.
  - (4) casing PVC 100  
 (material) (depth)  
4 if telescope see back.  
 (size)
  - (5) screen 10 100  
 (length) (depth to top)  
4 PVC  
 (size) (material)
  - (6) pump 1 25  
 (HP) (yield gpm)  
 (type power)
  - (7) electric log no  
 (yes or no)  
 (organization running log)
  - (8) how well bottom plugged and packed

DRILLERS REMARKS:

DEPT. OF NATURAL RESOURCES  
 BUREAU OF LAND & WATER RESOURCES  
 SEP 24 1984  
**RECEIVED**

If well telescopes please sketch and show depths.

GROUND LEVEL

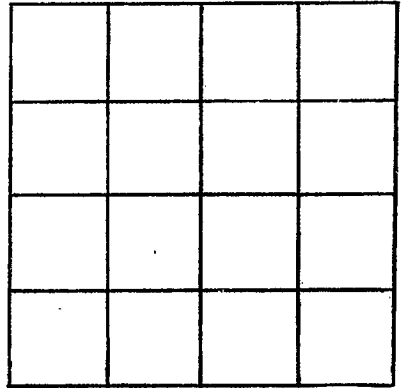

SECTION \_\_\_\_\_

Please indicate well location X.

ADDITIONAL INFORMATION

If more than one screen,  
show locations of each on sketch.