

MISSISSIPPI DEPARTMENT OF NATURAL RESOURCES

Bureau of Land and Water Resources

Southport Mall

P.O. Box 10631

Jackson, Mississippi 39209

WATER WELL DRILLERS LOG

Warren  
E 2004

March 20 1987 E. M. Bud General Warren  
 date well completed firm name county well located

LANDOWNER:	description of formations encountered	from	to
(mailing address)			
<u>David L May</u> <u>Vicksburg, Ms.</u>	<u>Surface deposit</u> <u>Sand - gravel</u>	<u>0</u> <u>15</u>	<u>15</u> <u>130</u>
WELL LOCATION:			
sec. <u>2</u> T <u>17</u> N R. <u>3</u> E			
<u>5</u> miles <u>North</u> of <u>Vicksburg</u>			
(distance) (direction) (nearest town)			
WELL PURPOSE: <u>Home</u>			
(home, irrigation, municipal, industrial)			
WELL COMPLETION DATA:			
(1) diameter (inches) <u>4</u>			
(2) total depth (feet) <u>130</u>			
(3) static water level (feet) <u>22</u> below top of ground.			
(4) casing <u>PVC</u> <u>110</u>			
(material) (depth)			
<u>4</u> if telescope see back.			
(size)			
(5) screen <u>20</u> <u>110</u>			
(length) (depth to top)			
<u>4</u> <u>PVC</u>			
(size) (material)			
(6) pump <u>1</u> <u>20</u>			
(HP) (yield gpm)			
(type power)			
(7) electric log <u>No</u>			
(yes or no)			
(organization running log)			
(8) how well bottom plugged <u>Land Shark</u>			

RECEIVED


APR 14 1987

Department of Natural Resources  
 Bureau of Land & Water Resources

DRILLERS REMARKS:

If well telescopes please  
sketch and show depths.

GROUND LEVEL

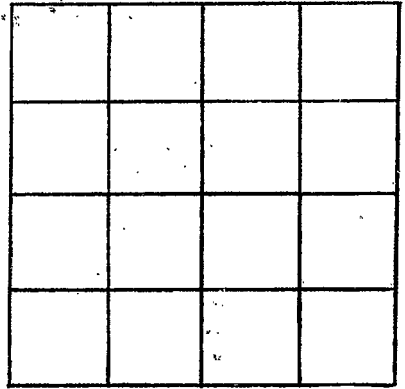

SECTION \_\_\_\_\_

Please indicate well location X.

ADDITIONAL INFORMATION

If more than one screen,  
show locations of each on sketch.