

F
9-16-63

WATER WELL DRILLERS LOG

11

Date: 9/16, 1963, Driller: Bailey Drilling Co County Washington
(Name)

(1) Owner of Land: Warren County
(Name)
Redwood School
(Address)

(2) Location: $\frac{1}{4}$, $\frac{1}{4}$, Sec. T R ,
 miles of
(distance) (direction) (Nearest Town)

(3) Topography: Level
(Hilly) (Flat) (Level)

(4) Purpose of Well: School
(Domestic Irrigation
Municipal, Industrial, Other)

Description & Color of Materials Sand, Clay, Red Clay, Shell, etc.	Thick-ness Feet	Depth Feet
<u>Waxy</u>		<u>20</u>
<u>Sand</u>		<u>60</u>
<u>Gravel</u>		<u>75</u>
<u>Blue mud</u>		<u>135</u>
<u>Sand</u>		<u>177</u>

Information upon completion of well:

(1) Diameter 4 inches.


(2) Total Depth 177 feet.

(3) Water Level 46 feet below top of ground.

(4) Cased to all way Size 4

(5) Screen: Size 2 1/2; Length 30

(6) Were any formations sealed against pollution?
 yes, X no.

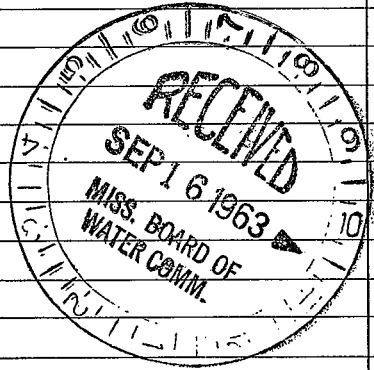

If YES depth of formation _____

Why _____

Drillers Remarks: _____

Well No.

(Use Back Side)

