

WARREN WATER WELL DRILLERS LOG

Date: 1/10, 1962, Driller: D.H. Williams County Warren
1-10-62 (Name)


(1) Owner of Land: Hugh Morris
(Name)
R of Vicksburg SUB DIV
(Address)
 On High 61 - 3 1/2 miles North Vicksburg
 (2) Location: 1/4, 1/4, Sec. T R
3 1/2 miles North, of Vicksburg
(distance) (direction) (Nearest Town)
 (3) Topography: Flat at Foot of Hills
(Hilly) (Flat) (Level)
 (4) Purpose of Well: Individual
(Domestic Irrigation Municipal, Industrial, Other)

Description & Color of Materials Sand, Clay, Red Clay, Shell, etc.	Thick- ness Feet	Depth Feet
Surface Clay 1 to 50	50	
50 to 100 Blue Gyms	50	
100 to 140	40	140
Vicksburg Lina Rock Formation		
Sub-Stream at Bottom of Lina Rock to Catch water Flowing Between The Lina Rock Layers		
Well drilled to 260' But no more water		
Forest Hill Sands. would not Pump		
140 to 260 mostly Forest Hill sands	120	260

Information upon completion of well:

(1) Diameter 4 1/2 inches.
 (2) Total Depth 260 feet.
 (3) Water Level 40 feet below top of ground.
 (4) Cased to 120, Size 2"
 (5) Screen: Size 2", Length 20 feet
 (6) Were any formations sealed against pollution?
 yes, no.

If YES depth of formation 10ft
 Why Keep back Top surface
Precautions
 Drillers Remarks:

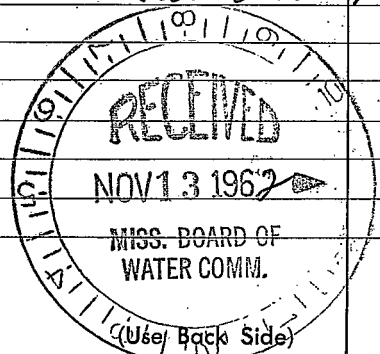

Well No.

1870

1871

1872

1873

1874

1875

1876

1877

1878

1879

1880

1881

1882