

6 F 11

2-26-63

WATER WELL DRILLERS LOG

CODED

Date: 3/26, 1963, Driller: C. P. Clark County Warren

(Name)

(1) Owner of Land: <u>Fount Beard</u> <u>Rt #3 Wicksburg Miss</u> (Name) (Address)	Description & Color of Materials Sand, Clay, Red Clay, Shell, etc.	Thick- ness Feet	Depth Feet
	<u>0-30 Sandy Clay</u> <u>20-223 sand + gravel</u> <u>+ Sandstone</u>	<u>20</u> <u>203</u>	
(2) Location: <u>1/4</u> , <u>1/4</u> , Sec. <u>91</u> T <u>17</u> R <u>4</u> <u>9</u> miles <u>N.E.</u> , of <u>Wicksburg</u> (distance) (direction) (Nearest Town)			
(3) Topography: <input checked="" type="checkbox"/> (Hilly) <input type="checkbox"/> (Flat) <input type="checkbox"/> (Level)			
(4) Purpose of Well: <u>Domestic</u> (Domestic Irrigation Municipal, Industrial, Other)			

Information upon completion of well:


- (1) Diameter 2 inches.
- (2) Total Depth 223 feet.
- (3) Water Level 165 feet below top of ground.
- (4) Cased to 205, Size 2 in
- (5) Screen: Size 1/4, Length 18 ft
- (6) Were any formations sealed against pollution?
_____ yes, no.

If YES depth of formation _____

Why _____

Drillers Remarks: _____

CODED

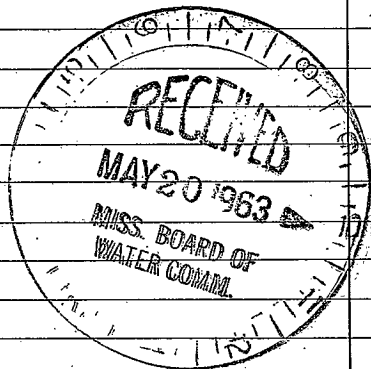

(Use Back Side)

Well No.

