

ELOG# 106

MISSISSIPPI
BOARD OF WATER COMMISSIONERS
416 North State Street
Jackson, Mississippi 39201

CODED

WARREN
MT F 18
10-22-71

WATER WELL DRILLERS LOG

Oct. 22 1971 of E.M. "Bud" Crosswell WARREN
date well completed firm name county well located

LANDOWNER:
Dad S. Miller, Dist.
Redwood, Miss-
(mailing address)

description of formations encountered	from	to
	Shale	0
Sand	100	175

WELL LOCATION:
sec. 3 T. 7 N. R. 4 E
at Redwood
(distance) miles (direction) of (nearest town)

WELL PURPOSE: private use
(home, irrigation, municipal, industrial)

- WELL COMPLETION DATA:**
- (1) diameter (inches) 3
 - (2) total depth (feet) 175
 - (3) static water level (feet) 30 below top of ground. gauge
 - (4) casing Steel 155
(material) (depth)
3 if telescope see back.
(size)
 - (5) screen 20 155
(length) (depth to top)
2 stainless
(size) (material)
 - (6) pump 1/2 10
(HP) (yield gpm)
(type power)
 - (7) electric log yes
(yes or no)
state
(organization running log)
 - (8) how well bottom plugged steel plug


CODED

DRILLERS REMARKS:

NOV 12 1971

If well telescopes please sketch and show depths.

GROUND LEVEL

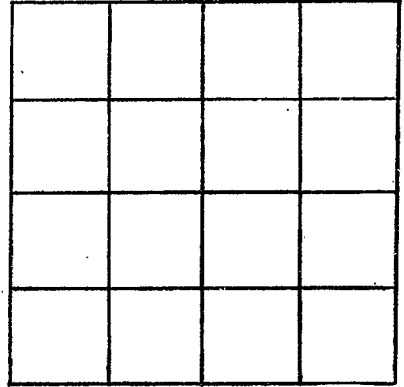

SECTION _____

Please indicate well location X.

ADDITIONAL INFORMATION

A series of horizontal lines providing space for additional information.

If more than one screen, show locations of each on sketch.