

CODED

MISSISSIPPI  
BOARD OF WATER COMMISSIONERS  
416 North State Street  
Jackson, Mississippi 39201

CODED

WATER WELL DRILLERS LOG

Warren
720
1-10-69

Jan 10 1969 *G. H. Barnes* Warren  
 date well completed firm name county well located


LANDOWNER: <i>T. H. McBrum</i>	description of formations encountered	from	to
<i>the Ridge Road</i>			
<i>Veeshing Miss</i> (mailing address)	<i>top soil</i>	<i>0</i>	<i>30</i>
	<i>Sharon Clay</i>	<i>70</i>	<i>90</i>
	<i>white clay</i>	<i>10</i>	<i>100</i>
	<i>Red Sandstone</i>	<i>8</i>	<i>108</i>
	<i>Sand &amp; Gravel</i>	<i>42</i>	<i>150</i>
WELL LOCATION: sec <i>25</i> T <i>7N</i> N R <i>4E</i> E S W <i>5</i> miles <i>N.E.</i> of <i>Veeshing</i> (distance) (direction) (nearest town)			
WELL PURPOSE: (home, irrigation, municipal, industrial)			
WELL COMPLETION DATA:			
(1) diameter (inches) <i>9"</i>			
(2) total depth (feet) <i>150</i>			
(3) static water level (feet) <i>100</i> below above top of ground.			
(4) casing <i>7 1/2"</i> <i>1 1/4"</i> (material) (depth) (size) if telescope see back.			
(5) screen <i>6'</i> <i>1 1/4"</i> (length) (depth to top) <i>2 1/2"</i> <i>Bison</i> (size) (material)			
(6) pump <i>1 1/2 HP</i> <i>5' Gal</i> (HP) (yield gpm) <i>Clad</i> (type power)			<i>150</i>
(7) electric log <i>no</i> (yes or no)			
(organization running log)			
(8) how well bottom plugged <i>Ball</i> <i>Plugged</i>			<i>150</i>
DRILLERS REMARKS:			

FEB 25 1969

MISS. DE. OF WATER COMMISSIONERS

If well telescopes please  
sketch and show depths.

GROUND LEVEL

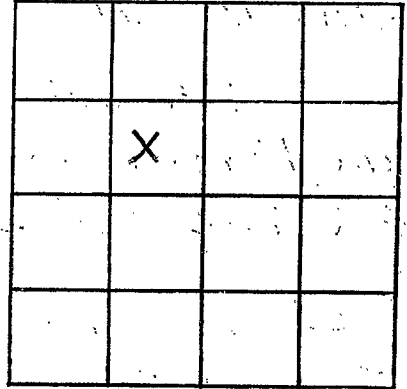

SECTION 25

Please indicate well location X.

ADDITIONAL INFORMATION

If more than one screen,  
show locations of each on sketch.