

**MISSISSIPPI  
BOARD OF WATER COMMISSIONERS**  
416 North State Street  
Jackson, Mississippi 39201

**CODED**

**WATER WELL DRILLERS LOG**

Warren  
721  
1-16-69

Jan 16 1969 J. H. Baines Warren  
date well completed firm name county well located

**LANDOWNER:** Jas. Embrey  
abe Ridge Road  
Vicksburg Miss.  
(mailing address)

description of formations encountered	from	to
<u>top soil</u>	<u>0</u>	<u>30</u>
<u>Brown Clay</u>	<u>30</u>	<u>100</u>
<u>Red sand &amp; gravel</u>	<u>8</u>	<u>108</u>
<u>sand &amp; gravel</u>	<u>45</u>	<u>153</u>

**WELL LOCATION:**  
sec. 25 T. 7N R. 16E  
S W  
5 miles NE of Vicksburg  
(distance) (direction) (nearest town)

**WELL PURPOSE:** home  
(home, irrigation, municipal, industrial)

**WELL COMPLETION DATA:**

- (1) diameter (inches) 2"
- (2) total depth (feet) 153
- (3) static water level (feet) 100 below above top of ground.
- (4) casing 2" 147  
(material) (depth)  
\_\_\_\_ (size) if telescope see back.
- (5) screen 6 feet 147  
(length) (depth to top)  
2" Brass  
(size) (material)
- (6) pump 1 1/2 HP 6 Gal.  
(HP) (yield gpm)  
Electric  
(type power)
- (7) electric log No  
(yes or no)
- (organization running log)
- (8) how well bottom plugged Plugged Bull

**DRILLERS REMARKS:**


**CODED**

**FEB 25 1969**  
MISS. DIV. OF  
WATER CONTROL

153

If well telescopes please sketch and show depths.

GROUND LEVEL

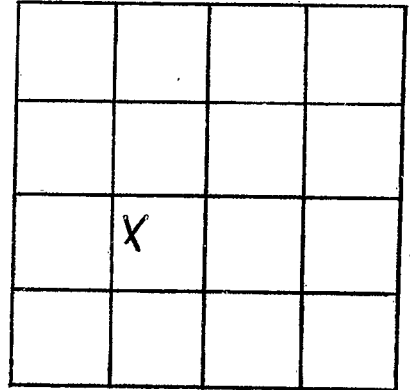

SECTION 25

Please indicate well location X.

ADDITIONAL INFORMATION

If more than one screen,  
show locations of each on sketch.