


WARREN
F 22
9-23-60
Date: 9/23, 1960

WATER WELL DRILLERS LOG

CODED
F 300
Driller: D.H. Williams
County: Warren
(Name)

(1) Owner of Land: Dr Blake
(Name)
Redwood Miss
(Address)
(2) Location: 1/4, 1/4, Sec. 15 T 17 R 4 E
1 miles South of Redwood
(distance) (direction) (Nearest Town)
(3) Topography: (Hilly) (Flat) (Level)
(4) Purpose of Well: Home & Stock
(Domestic Irrigation, Municipal, Industrial, Other)

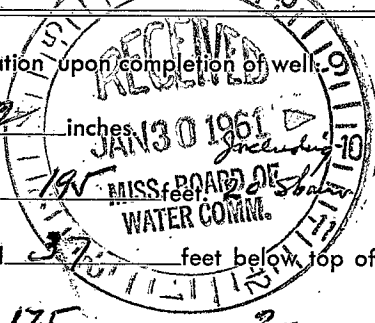

Information upon completion of well:
(1) Diameter 2 inches including 10 inches of casing
(2) Total Depth 175 feet
(3) Water Level 175 feet below top of ground
(4) Cased to 175, Size 2
(5) Screen: Size 2", Length 20 ft
(6) Were any formations sealed against pollution?
_____ yes _____ no.
If YES depth of formation 6 feet
Why Keep Back Surface water & mud
Drillers Remarks:
Well drilled in flat between files
Notice the Log

Description & Color of Materials Sand, Clay, Red Clay, Shell, etc.	Thick-ness Feet	Depth Feet
1 to 11 ft Clay Top Surface	11	11
4 to 15 Black Brittle Formation		
would Color Drilling Water	4	15
11 to 25 Clay (Gummy)	10	25
25 to 45, Sand + Pea Gravel + Screw Shape Shells		
Log 28" diameter at 43'	20	45
45 to 65 Sand + Pea Gravel + Shells		
24" Log at 62 feet	20	65
Bar + Cutting from Log floated like cork		
65 to 75 - Light Blue Sand	10	75
75 to 170 - Sand Pea Gravel + Shells		
Mostly Gravel + Shells	95	170
170 to 195 Fine Sand almost white	25	195
Set 20" 80 Gauge Screen at the Bottom of 175 2" casing		
Set 3/4 HP Jet Pumps at 93 feet = Pump 6 Gal Per minute		

(Use Back Side)

Well No.

