

C. P. CLARK
 WATER WELL DRILLING
 ROUTE 2

MISSISSIPPI LAUREL, MISS. 39440
 BOARD OF WATER COMMISSIONERS
 416 North State Street
 Jackson, Mississippi 39201

CODED

WATER WELL DRILLERS LOG

WARREN
E24
7-68

7/26 1968 *C. P. Clark* Warren
 date well completed firm name county well located

LANDOWNER: *H. I. Breckan*
General Delivery
Redwood Miss
 (mailing address)

description of formations encountered	from	to
	<i>0-85 Brown clay</i>	<i>0</i>
<i>85-120 Sand & Grail</i>	<i>85</i>	<i>120</i>
<i>Matches Sandstone</i>	<i>120</i>	<i>158</i>

WELL LOCATION:
 sec. *13* T *9N* R. *4E*
2 miles *SE* of *Redwood*
 (distance) (direction) (nearest town)

WELL PURPOSE: *Home*
 (home, irrigation, municipal, industrial)

WELL COMPLETION DATA:

- (1) diameter (inches) 2
 (2) total depth (feet) 158
 (3) static water level (feet) 145 below above top of ground.
 (4) casing *Galv crown*
 (material) (depth)

_____ If telescope see back.
 (size)

- (5) screen 10 , 148
 (length) (depth to top)
1/4 , S.S.
 (size) (material)


- (6) pump 2 3 1/2
 (HP) (yield gpm)
220 V Single P.
 (type power)

- (7) electric log no
 (yes or no)

_____ (organization running log)

- (8) how well bottom plugged B.W.U

DRILLERS REMARKS:

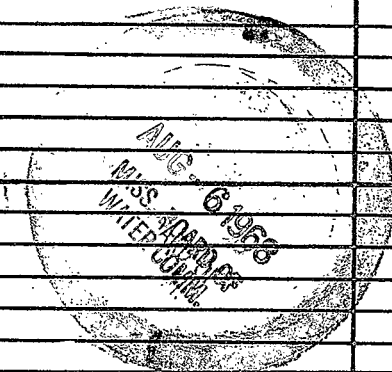

If well telescopes please sketch and show depths.

GROUND LEVEL

			+
			●

SECTION 13

Please indicate well location X.

ADDITIONAL INFORMATION

If more than one screen,
show locations of each on sketch.