

Warren  
 8-65

MISSISSIPPI BOARD OF WATER COMMISSIONERS

F25

WATER WELL DRILLERS LOG

**CODED**

Date: 8-3-65, 19<sup>65</sup>, Driller: Layne-Central Co. County: Warren

(Name)

(1) Owner of Land: Kings Water Club, Inc.

(Name)

Description & Color of Materials Sand, Clay, Red Clay, Shell, etc.	Thick-ness Feet	Depth Feet
sandy clay	12	12
clay	24	36
fine sand-clay stks	44	80
coarse sand-pea gravel	46	126
blue clay	1	127

Vicksburg, Mississippi

(Address)

(2) Location: SW 1/4, SW 1/4, Sec. 31 T17R9E

\_\_\_\_\_ miles \_\_\_\_\_ of \_\_\_\_\_  
 (distance) (direction) (Nearest Town)

(3) Topography: \_\_\_\_\_  
 (Hilly) (Flat) (Level)

(4) Purpose of Well: Municipal  
 (Domestic Irrigation, Municipal, Industrial, Other)

**CODED**

Information upon completion of well:

(1) Diameter 12 inches.

(2) Total Depth 127 feet.

(3) Water Level 28 feet below top of ground.

(4) Cased to 85' 5", Size 8"


(5) Screen: Size 6", Length 40'

(6) Were any formations sealed against pollution?  
 yes, \_\_\_\_\_ no.

If YES depth of formation 85' 5"

Why \_\_\_\_\_ required

Drillers Remarks: \_\_\_\_\_

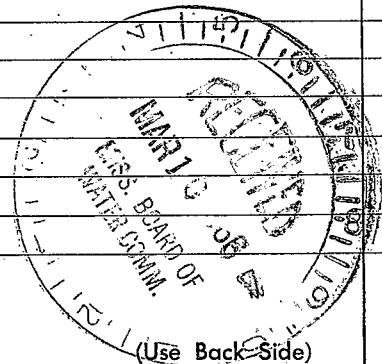

(Use Back Side)

Well No.

(X)

1000