

WARREN
F28
3-17-71

MISSISSIPPI
BOARD OF WATER COMMISSIONERS
416 North State Street
Jackson, Mississippi 39201

CODED

WATER WELL DRILLERS LOG

March 17 1971 *M. J. Connell Drilling* Warren
date well completed firm name county well located

LANDOWNER:
L. B. Whitaker
Red Wood Miss.
(mailing address)

description of formations encountered	from	to
<i>Yellow clay</i>	0	11
<i>lime & marble</i>	11	47
<i>Blue clay & sand-</i>	47	128
<i>sand-</i>	128	184

WELL LOCATION:
sec. *5* T. *17* N R. *4* E
1 1/2 miles *E* of *Redwood*
(distance) (direction) (nearest town)

WELL PURPOSE: *home*
(home, irrigation, municipal, industrial)

CODED

WELL COMPLETION DATA:

(1) diameter (inches) *4"*

(2) total depth (feet) *184"*

(3) static water level (feet) *59* below top of ground.

(4) casing *steel*, *169'*
(material) (depth)
4" if telescope see back.
(size)

(5) screen *15'*, *169'*
(length) (depth to top)
2", *stainless*
(size) (material)

(6) pump *1/2*, *10*
(HP) (yield gpm)
Elect
(type power)

(7) electric log *N/A*
(yes or no)

(organization running log)

MAR 23 1971


MISC. BD. OF
WATER COMMISSIONERS

(8) how well bottom plugged:
Back wash valve

DRILLERS REMARKS:
Gravel packed

If well telescopes please
sketch and show depths.

GROUND LEVEL

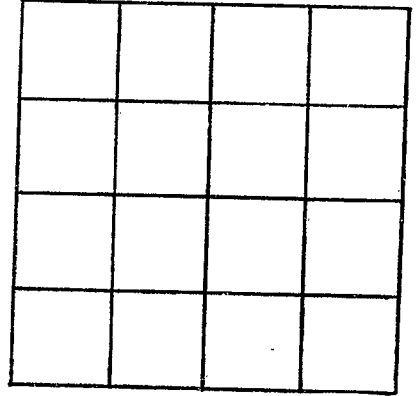

SECTION _____

Please indicate well location X.

ADDITIONAL INFORMATION

If more than one screen,
show locations of each on sketch.