

WARREN  
F30  
3-9-73

MISSISSIPPI  
BOARD OF WATER COMMISSIONERS  
416 North State Street  
Jackson, Mississippi 39201

**CODED**

WATER WELL DRILLERS LOG

March 9 1973 E.M. "Bud" Cresswell WARREN  
date well completed firm name county well located

LANDOWNER: C. C. Thrash  
Redwood, Miss.  
(mailing address)

description of formations encountered: Clay Sand & gravel

from	to
0	25
25	95

WELL LOCATION:  
sec. 4 T. 19 N R. 4 E  
2 17 W of Redwood  
(distance) (direction) (nearest town)

WELL PURPOSE: Home  
(home, irrigation, municipal, industrial)

WELL COMPLETION DATA:

(1) diameter (inches) 2

(2) total depth (feet) 94

(3) static water level (feet) 19 below top of ground.

(4) casing Steel, 84 (material) (depth)  
2 (size) if telescope see back.

(5) screen 10, 84 (length) (depth to top)  
2, stainless (size) (material)

(6) pump 1, 15 (HP) (yield gpm)  
0 (type power)

(7) electric log No (yes or no)  
(organization running log)

(8) how well bottom plugged: Steel plug


**CODED**

DRILLERS REMARKS:

BOARD OF WATER COMMISSIONERS

If well telescopes please  
sketch and show depths.

GROUND LEVEL

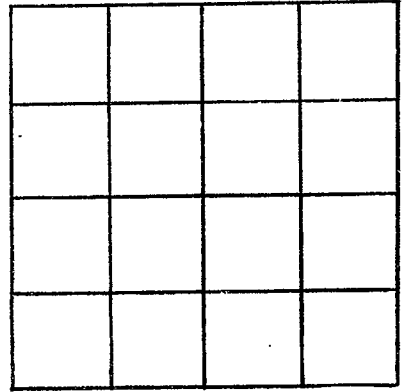

SECTION \_\_\_\_\_

Please indicate well location X.

ADDITIONAL INFORMATION

If more than one screen,  
show locations of each on sketch.