

WARREN  
F 35  
12-4-80

MISSISSIPPI  
BOARD OF WATER COMMISSIONERS  
416 North State Street  
Jackson, Mississippi 39201

CODED

WATER WELL DRILLERS LOG

Dec. 4 1980 E.M. "Bud" Cresswell WARREN  
date well completed firm name county well located

LANDOWNER:  
International Paper Co.  
Redwood, Ms.  
(mailing address)

description of formations encountered	from	to
Clay	0	40
Hard-gravel	40	140

WELL LOCATION:  
sec. 18 T 7 N R 4 E  
4 miles N of Vicksburg  
(distance) (direction) (nearest town)

WELL PURPOSE: Industrial  
(home, irrigation, municipal, industrial)

CODED

- WELL COMPLETION DATA:
- (1) diameter (inches) 4
  - (2) total depth (feet) 140
  - (3) static water level (feet) 25 below top of ground
  - (4) casing PVC 100 (material) (depth)  
4 (size) if telescope see back.
  - (5) screen 40 160 (length) (depth to top)  
4 PVC (size) (material)
  - (6) pump 5 100 (HP) (yield gpm)
  - (type power)
  - (7) electric log No (yes or no)
  - (organization running log)
  - (8) how well bottom plugged SAND SHARP

DRILLERS REMARKS:


DEPT. OF NATURAL RESOURCES  
BUREAU OF LAND & WATER RESOURCES

DEC 29 1980

RECEIVED

If well telescopes please sketch and show depths.

GROUND LEVEL

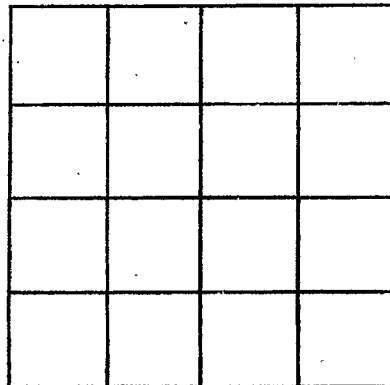

SECTION \_\_\_\_\_

Please indicate well location X.

ADDITIONAL INFORMATION

If more than one screen,  
show locations of each on sketch.