

WARREN

MISSISSIPPI BOARD OF WATER CONTROL ENGINEERS

F 5000
8-8-60

WATER WELL DRILLERS LOG

Date: 8-8, 1960, Driller: Arthur County Warren
(Name)

(1) Owner of Land: H. E. Settnay
(Name)
Wicksburg miss
(Address)

(2) Location: $\frac{1}{4}$, $\frac{1}{4}$, Sec. 3 12 15
5 miles North of Wicksburg
(distance) (direction) (Nearest Town)

(3) Topography: Flat
(Hilly) (Flat) (Level)

(4) Purpose of Well: Home
(Domestic Irrigation
Municipal, Industrial, Other)

Description & Color of Materials
Sand, Clay, Red Clay, Shell, etc.

Thick-
ness
Feet

Depth
Feet

0-69 clay
69-117 red

Information upon completion of well:

(1) Diameter 2 inches.

(2) Total Depth 117 feet.

(3) Water Level 22 feet below top of ground.

(4) Cased to 111, Size 2


(5) Screen: Size 2, Length 6

(6) Were any formations sealed against pollution?
_____ yes, no no.

If YES depth of formation _____

Why _____

Drillers Remarks: _____

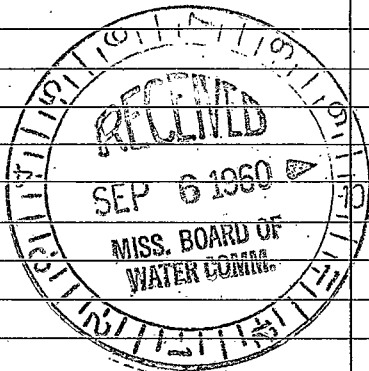

(Use Back Side)

Well No.

