

WARREN

WATER WELL DRILLERS LOG

Dec 7-302

Date: Jan 28 1961, Driller: D.H. Williams County Warren
Lat 7 - South Brifield Sub. (Name)

(1) Owner of Land: Lillie K. Turner
 (Name)
Vicksburg 3 1/2 miles north on 61 Hwy
 (Address)
Sec 40-41 Range 4 T 11 R
 (2) Location: 1/4, 1/4, Sec. T. R.
3 1/2 miles north on 61 of Vicksburg
 (distance) (direction) (Nearest Town)
 (3) Topography: Flat
 (Hilly) (Flat) (Level)
 (4) Purpose of Well: Domestic
 (Domestic Irrigation, Municipal, Industrial, Other)


Description & Color of Materials Sand, Clay, Red Clay, Shell, etc.	Thick- ness Feet	Depth Feet
Located on West Side of Hwy		
1 to 45 ft Black Surface Formation		
45 to 70' Lime Formation		
70 to 100' Vicksburg Lime Rock		
100 to 155' all Lime & Sandy Formation		
155 to 160 Black Gumbo Shale Shale		
160 to 168 Sand & Gumbo		
168 to 180 Gumbo Shale		
180 to 185 5 ft Grey Sandy Formation		
185 to 224 Grey Sand Fine (Forest Hill)		
224 - 240 Blue Shale Hard		

Information upon completion of well:

(1) Diameter 2 inches.
 (2) Total Depth 240 feet.
 (3) Water Level 30 feet below top of ground.
 (4) Cased to 196', Size 2"
 (5) Screen: Size 2, Length 20 ft
 (6) Were any formations sealed against pollution?
Yes 7 ft down to 8 ft no.
 If YES depth of formation 7 ft to 8 ft
 Why Keep out Surface water

Set 20 ft 90 Ga Straws
196 to 216
Packed Bed Gravel
up to 176'
Fairbanks Morris Rod 1/2 HP
Pumps
Cylinder Set 147 - to 149
82 Gal Pressure Tank
2-1" Wash Out Valves
on end of Straws

Drillers Remarks:
Screen Gravel Packed
40' up from Bottom of Screen

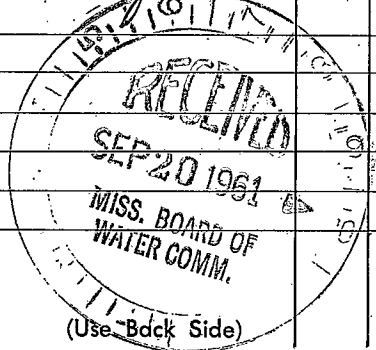

Well No.

