

WARREN  
 F 2003  
 5-19-80

MISSISSIPPI  
 BOARD OF WATER COMMISSIONERS  
 416 North State Street  
 Jackson, Mississippi 39201

WATER WELL DRILLERS LOG

May 19 1980 date well completed      F. M. "Bud" Russell firm name      WARREN county well located

LANDOWNER:	description of formations encountered	from	to
C. E. Moseley Redwood, Mo. (mailing address)	Clay Sand - gravel	0 30	30 120
<b>WELL LOCATION:</b> sec. 4 T 17 N R 4 E 1 miles West of Redwood (distance) (direction) (nearest town)			
<b>WELL PURPOSE:</b> home (home, irrigation, municipal, industrial)			
<b>WELL COMPLETION DATA:</b>			
(1) diameter (inches) 2			
(2) total depth (feet) 120			
(3) static water level (feet) 15 below top of ground.			
(4) casing PVC 100 (material) (depth)			
2 if telescope see back. (size)			
(5) screen 20 100 (length) (depth to top)			
2 PVC (size) (material)			
(6) pump 1 10 (HP) (yield gpm)			
(type power)			
(7) electric log no (yes or no)			
(organization running log)			
(8) how well bottom plugged Sand pack			
<b>DRILLERS REMARKS:</b>			


DEPT. OF NATURAL RESOURCES  
 BUREAU OF LAND & WATER RESOURCES

MAY 28 1980

RECEIVED

If well telescopes please  
sketch and show depths.

GROUND LEVEL

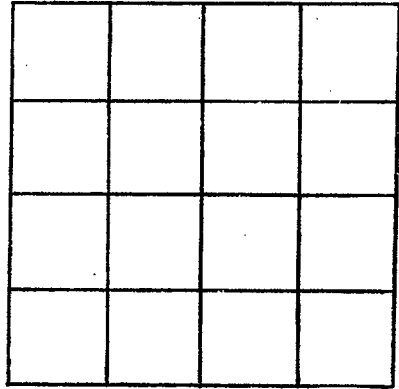

SECTION \_\_\_\_\_

Please indicate well location X.

ADDITIONAL INFORMATION

If more than one screen,  
show locations of each on sketch.