

MISSISSIPPI DEPARTMENT OF NATURAL RESOURCES

Bureau of Land and Water Resources

Southport Mall

P.O. Box 10631

Jackson, Mississippi 39209

WATER WELL DRILLERS LOG

WARREN
F 2004
6-4-81

June 4 1981 E.M. "Bud" CRESSWELL WARREN
 date well completed firm name county well located

LANDOWNER:	description of formations encountered	from	to
Richard F. Cook Redwood, Ms. (mailing address)			
WELL LOCATION: sec. 4 T. 17 N R. 4 E 1 miles West of Redwood (distance) (direction) (nearest town)			
WELL PURPOSE: Home (home, irrigation, municipal, industrial)			
WELL COMPLETION DATA:			
(1) diameter (inches) 2			
(2) total depth (feet) 110			
(3) static water level (feet) 22 below top of ground. charge			
(4) casing PVC 100 (material) (depth) 2 (size) if telescope see back.			
(5) screen 10 100 (length) (depth to top) 2 PVC (size) (material)			
(6) pump 1 10 (HP) (yield gpm) (type power)			
(7) electric log no (yes or no) (organization running log)			
(8) how well bottom plugged backfilled valve			

DEPT. OF NATURAL RESOURCES
BUREAU OF LAND & WATER RESOURCES


JUN 18 1981

RECEIVED

DRILLERS REMARKS:

If well telescopes please sketch and show depths.

GROUND LEVEL

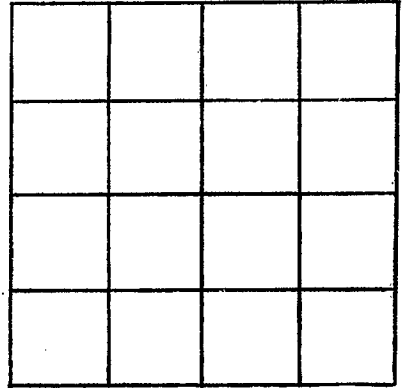

SECTION _____

Please indicate well location X.

ADDITIONAL INFORMATION

If more than one screen,
show locations of each on sketch.